

Pearl River  
T 26  
5-67

MISSISSIPPI  
BOARD OF WATER COMMISSIONERS  
416 North State Street  
Jackson, Mississippi

13V

CODED

WATER WELL DRILLERS LOG  
NEIL LUMPKIN WELL

DRILLING SERVICE

PEARL RIVER

5-3  
date well completed

1967  
firm name

county well located


LANDOWNER: MAC DONALD  
REALTY Co.  
PICAUNE, MISS.  
(mailing address)  
WELL LOCATION:  
sec. 19 T 5 S R 18 W  
13 miles WEST of PICAUNE  
(distance) (direction) (nearest town)

description of formations encountered	from	to
Red clay	0	10
white sand & gravel	10	60
Blue clay	60	135
grey sand	135	200
Blue clay	200	250
	250	400
	400	800
	800	862

WELL PURPOSE: INDUSTRIAL  
(home, irrigation, municipal, industrial)

WELL COMPLETION DATA:  
(1) diameter (inches) 3  
(2) total depth (feet) 862  
(3) static water level (feet) 124 above top of ground.  
(4) casing (material) (depth)  
If telescope see back.  
(size)  
(5) screen 20' (length) 840' (depth to top)  
3" (size) St. Steel (material)  
(6) pump (HP) 150 (yield gpm)  
(type power)  
(7) electric log no (yes or no)  
no (organization running log)  
(8) how well bottom plugged back pressure valve

CODED

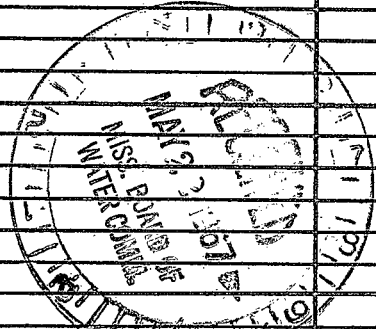

DRILLERS REMARKS: one of the best artesian I ever drilled - flowed about 100 gal per minute

25 psi pressure

If well telescopes please sketch and show depths.

GROUND LEVEL

X			

SECTION 19

Please indicate well location X.

ADDITIONAL INFORMATION

If more than one screen, show locations of each on sketch.