

Pearl River
 T 27
 7-67

MISSISSIPPI
 BOARD OF WATER COMMISSIONERS
 416 North State Street
 Jackson, Mississippi 39201

CODED

WATER WELL DRILLERS LOG

7-19-67 19 Neil Lumpkin Well Pearl River
 date well completed Drilling firm name Service county well located

LANDOWNER: N.P. Smith
 Industrial Community
 Picayune, Miss.
 (mailing address)

description of formations encountered	from	to
white clay	0	20
sand & gravel	20	90
blue clay	90	150
good sand	150	295
blue clay	295	400
good sand	400	550
Hard Shale	550	700
good sand	700	778


WELL LOCATION:
 sec. 31 T-5 S R-18 W
 1/2 miles west of Picayune
 (distance) (direction) (nearest town)

WELL PURPOSE: home
 (home, irrigation, municipal, industrial)

- WELL COMPLETION DATA:
- (1) diameter (inches) 2"
 - (2) total depth (feet) 778'
 - (3) static water level (feet) 41' above top of ground.
 - (4) casing 1 1/2" (material) 754' (depth)
 2" (size) if telescope see back.
 - (5) screen 21' (length) (depth to top)
 2" (size) St. Steel (material)
 - (6) pump (HP) (yield gpm)
 (type power)
 - (7) electric log no (yes or no)
 (organization running log)
 - (8) how well bottom plugged Johnson
 B.P. Valve.


DRILLERS REMARKS: 18 lbs. pressure

CODED

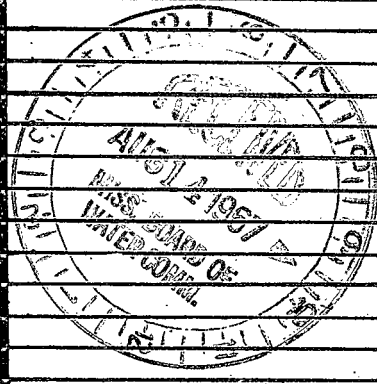

If well telescopes please sketch and show depths.

GROUND LEVEL

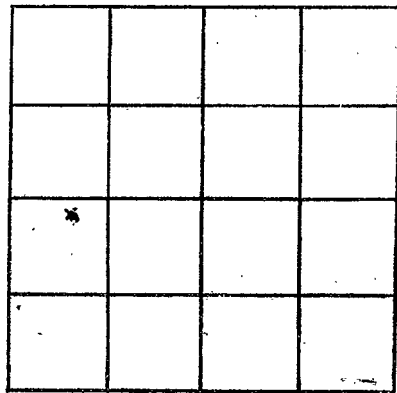

SECTION 31

Please indicate well location X.

ADDITIONAL INFORMATION

If more than one screen, show locations of each on sketch.