

PEARL RIVER

T 28

8-1-78

MISSISSIPPI BOARD OF WATER COMMISSIONERS 416 North State Street Jackson, Mississippi 39201

CODED

WATER WELL DRILLERS LOG

8/7

78 Budgents Inc

Jackson

date well completed

firm name

county well located

LANDOWNER: Edward W. ...

description of formations encountered

from to

Picayune Miss

white shale, white sand, blue sand, blue sand, blue shale, blue sand, blue shale, blue sand, blue shale, Day sand

0 30, 30 120, 120 360, 360 450, 450 735, 735 856, 856 930, 930 960, 960 980, 980 1018

(mailing address)

WELL LOCATION:

sec. 28 T 5 N R 18 E 8 miles W of Picayune

WELL PURPOSE: home (home, irrigation, municipal, industrial)

WELL COMPLETION DATA:

- (1) diameter (inches) 2"
(2) total depth (feet) 1018 ft
(3) static water level (feet) 21 1/2 below top of ground
(4) casing 998 (material) (depth)
(5) screen 2x20 998 (length) (depth to top)
(6) pump 2 1/2 (HP) (yield gpm)
(7) electric log no (yes or no)

CODED

(organization running log)

(8) how well bottom plugged


DRILLERS REMARKS:

RECEIVED OCT 4 1978

MISS. DE. OF WATER CONTROL

If well telescopes please sketch and show depths.

GROUND LEVEL

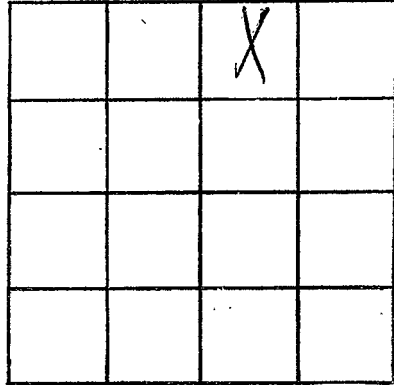

SECTION _____

Please indicate well location X.

ADDITIONAL INFORMATION

Lined area for additional information.

If more than one screen, show locations of each on sketch.