

Pearl River
T 30
E-69

MISSISSIPPI
BOARD OF WATER COMMISSIONERS CODED
416 North State Street
Jackson, Mississippi 39201

WATER WELL DRILLERS LOG

6-19-1969 DATE WELL COMPLETED
WELL LUMPKIN WELL DRILLING SERVICE Pearl River
P. O. BOX 117
CARROLL, MISS. county well located

LANDOWNER: Lt. Burges
Carriere, Miss.
Route 1
(mailing address)

description of formations encountered	from	to
Surface clay	0	10
" sand	10	70
Hard blue clay	70	250
Finest better sand	250	300

WELL LOCATION:
sec. 35 T 5 S R 18 E
7 miles west of Carriere
(distance) (direction) (nearest town)

WELL PURPOSE: home
(home, irrigation, municipal, industrial)

- WELL COMPLETION DATA:
- (1) diameter (inches) 2"
 - (2) total depth (feet) 300'
 - (3) static water level (feet) 100 below above top of ground.
 - (4) casing galv. 294'
(material) (depth)
2" if telescope see back.
(size)
 - (5) screen 5'
(length) (depth to top)
2" St. Steel
(size) (material)
 - (6) pump 1 420 g. per
(HP) (yield gpm)
electric
(type power)
 - (7) electric log No.
(yes or no)

(organization running log)

(8) how well bottom plugged back
pressure valve


DRILLERS REMARKS:

JUN 14 1969

MISS. B.D. OF
WATER COMMISSIONERS

If well telescopes please sketch and show depths.

GROUND LEVEL

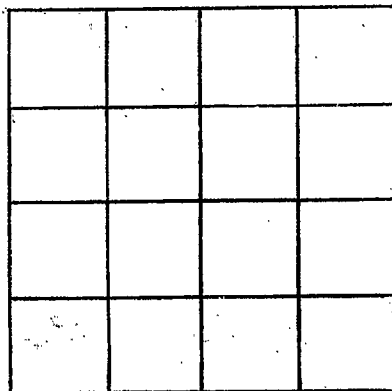

SECTION _____

Please indicate well location X.

ADDITIONAL INFORMATION

If more than one screen, show locations of each on sketch.