

Pearl River
T 31
1-9-70

MISSISSIPPI
BOARD OF WATER COMMISSIONERS
416 North State Street
Jackson, Mississippi 39201

CODED

WATER WELL DRILLERS LOG

1-9 1970 Penton Well Serv Pearl River
date well completed firm name county well located

LANDOWNER: Howard Sharp
P.O. Box 761
Picayune MISS
(mailing address)

WELL LOCATION:
sec. 28 T 5 S R 18 E
6 miles NW of Picayune
(distance) (direction) (nearest town)

WELL PURPOSE: Home
(home, irrigation, municipal, industrial)

WELL COMPLETION DATA: 5 Drilled

- (1) diameter (inches) 2"
(2) total depth (feet) 880
(3) static water level (feet) Flow ^{below} above top of ground.
(4) casing Black steel 860
(material) (depth)
2"
(size) if telescope see back.
(5) screen 20' 860
(length) (depth to top)
2" S. steel
(size) (material)
(6) pump ✓ 46
(HP) (yield gpm)
NO
(type power)
(7) electric log NO
(yes or no)
(organization running log)
(8) how well bottom plugged BW Valve

description of formations encountered	from	to
Surface Clay	0	16
Sand + Gravel	16	75
Blue Clay	75	80
Fine Sand	80	125
Blue Clay	125	265
Grey Sand	265	348
Blue Clay	348	415
Mud	415	440
Grey Sand	440	498
Blue Clay	498	585
Grey Sand	585	610
Blue Clay	610	798
Grey Sand	798	880


FEB 11 1970

MISS. BD. OF
WATER COMMISSIONERS

DRILLERS REMARKS:

If well telescopes please sketch and show depths.

GROUND LEVEL

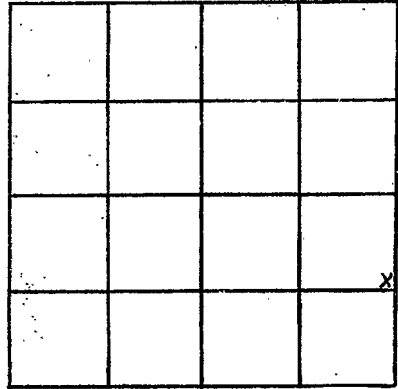

SECTION 28

Please indicate well location X.

ADDITIONAL INFORMATION

If more than one screen,
show locations of each on sketch.