

Pearl River  
T 32  
1/10/79

MISSISSIPPI  
BOARD OF WATER COMMISSIONERS  
416 North State Street  
Jackson, Mississippi 39201

CODED

WATER WELL DRILLERS LOG

1/70 19 79 Bud Peterson & Son Pearl River  
date/well completed firm name county well located

LANDOWNER: Bernie Lupton  
R.T. 3 Box  
Pocahontas Miss.  
(mailing address)

WELL LOCATION:  
sec 35 T 8 S R 18 E  
6 miles (distance) W (direction) of Prague (nearest town)

WELL PURPOSE: Home  
(home, irrigation, municipal, industrial)

WELL COMPLETION DATA:  
(1) diameter (inches) 2"  
(2) total depth (feet) 1009  
(3) static water level (feet) 22 below above top of ground.  
(4) casing 900' (material) 1009' (depth)  
(size) If telescope see back.  
(5) screen 2x20 (length) 908' (depth to top)  
12 (size) 1/2" steel (material)  
(6) pump (HP) (yield gpm)  
(type power)  
(7) electric log no (yes or no)  
(organization running log)  
(8) how well bottom plugged Sand short

Description of formations encountered	from	to
Red shale	0	21
White sand	21	120
Blue shale	120	390
Blue sand	390	460
Blue shale	460	580
Blue sand	580	652
Blue shale	652	820
Blue sand	820	900
Blue shale	900	1009
Gray sand	960	1009

CODED

Miss. Board of Water Comm.


FEB 26 1979

RECEIVED

DRILLERS REMARKS:

If well telescopes please  
sketch and show depths.

GROUND LEVEL

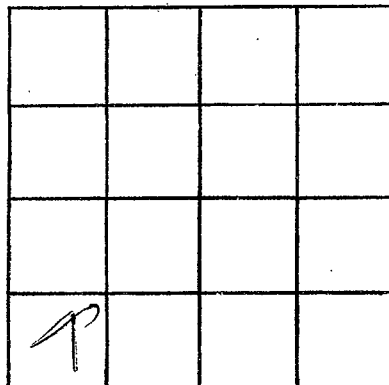

SECTION \_\_\_\_\_

Please indicate well location X.

ADDITIONAL INFORMATION

If more than one screen,  
show locations of each on sketch.