

Pearl River  
T33  
1/9/79

MISSISSIPPI  
BOARD OF WATER COMMISSIONERS  
416 North State Street  
Jackson, Mississippi 39201

WATER WELL DRILLERS LOG

1/9 date well completed 1979 Pearl River & Son Water Pearl River firm name Pearl River county well located

LANDOWNER: Joe W. Blaugher  
R. T. 2 Box 181 Piqueno  
Miss. (mailing address)

WELL LOCATION:  
sec. 28 T. 5 N. R. 18 E  
8 miles NW of Piqueno  
(distance) (direction) (nearest town)

WELL PURPOSE: home  
(home, irrigation, municipal, industrial)

WELL COMPLETION DATA:  
(1) diameter (inches) 2 1/2  
(2) total depth (feet) 1149  
(3) static water level (feet) 18 below/above top of ground.  
(4) casing 900 (material), 1149 (depth)  
(size) if telescope see back.  
(5) screen 2x20 (length), 1129 (depth to top)  
12 (size), S Steel (material)  
(6) pump (HP) (yield gpm)  
(type power)  
(7) electric log NO (yes or no)  
(organization running log)  
(8) how well bottom plugged Sand Shale

description of formations encountered	from	to
White Shale	0	18
White Sand Rock	18	96
Blue Shale	96	265
Blue sand	265	372
Blue Shale	372	620
Blue sand	620	725
Blue Shale	725	1100
Gray sand	1100	1145

Miss. Board of Water Comm.


FEB 26 1979

RECEIVED

DRILLERS REMARKS:

If well telescopes please sketch and show depths.

GROUND LEVEL

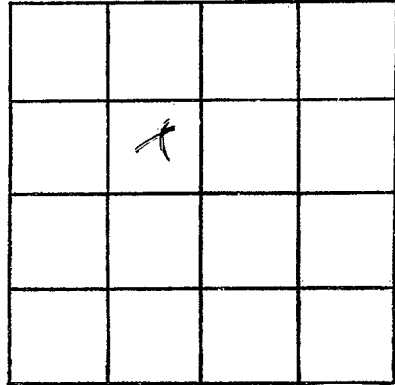

SECTION \_\_\_\_\_

Please indicate well location X.

ADDITIONAL INFORMATION

If more than one screen, show locations of each on sketch.