

PEARL RIVER
T 34
9-18-79

MISSISSIPPI
BOARD OF WATER COMMISSIONERS
416 North State Street
Jackson, Mississippi 39201

CODED

WATER WELL DRILLERS LOG

9-18-79 19 date well completed
Penton Well Serv firm name
Pearl River county well located

LANDOWNER: W.A. Bill Stewart
911 Ozk Dr.
Picayune MS.
(mailing address)

WELL LOCATION:
sec. 21 T. 5 S R. 18 W
8 miles N.W. of Picayune
(distance) (direction) (nearest town)

WELL PURPOSE: home
(home, irrigation, municipal, industrial)

WELL COMPLETION DATA:

(1) diameter (inches) 2"

(2) total depth (feet) 1150'

(3) static water level (feet) Flow below top of ground.

(4) casing Galv (material), 1130' (depth)
2" (size) if telescope see back.

(5) screen 20' (length), 1130' (depth to top)
2" (size), S. Steel (material)

(6) pump (HP) (yield gpm)
(type power)

(7) electric log NO (yes or no)
(organization running log)

(8) how well bottom plugged Bw Valve

description of formations encountered	from	to
Surface Clay	0	15
Sand + Gravel	15	60
Blue Clay	60	280
Sand	280	400
Blue Clay	400	780
Sand	780	835
Blue Clay	835	890
Sand	890	955
Blue clay	955	1080
Sand	1080	1150


CODED

rec'd 10-2-79
D.W.

DRILLERS REMARKS:

If well telescopes please sketch and show depths.

GROUND LEVEL

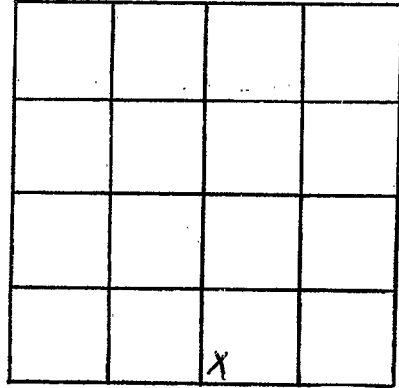

SECTION 21

Please indicate well location X.

ADDITIONAL INFORMATION

A series of horizontal lines for writing additional information.

If more than one screen, show locations of each on sketch.