

Pearl River  
T 39  
2-14-70

MISSISSIPPI  
BOARD OF WATER COMMISSIONERS  
416 North State Street  
Jackson, Mississippi 39201

CODED

WATER WELL DRILLERS LOG

2-14 1970 NEIL HUMPHREY WELL Pearl River  
date well completed DR. G. firm name SERVICE county well located

LANDOWNER: <u>Billy Cooper</u> <u>Picayune, Miss.</u> <u>Rt. 2, Box 231</u> (mailing address)	description of formations encountered	from	to
WELL LOCATION: sec. <u>22</u> T. <u>5</u> S. R. <u>18</u> W. <u>13</u> miles <u>NW</u> of <u>Picayune</u> (distance) (direction) (nearest town)	Surface clay	0	10
WELL PURPOSE: <u>home</u> (home, irrigation, municipal, industrial)	sand & gravel, bad	10	30
WELL COMPLETION DATA: (1) diameter (inches) <u>2</u> (2) total depth (feet) <u>924</u> (3) static water level (feet) _____ below above top of ground. (4) casing <u>blk</u> (material) _____ (depth) _____ <u>2"</u> (size) If telescope see back. (5) screen <u>20'</u> (length) _____ (depth to top) _____ <u>St. Steel</u> (size) (material) (6) pump _____ (HP) _____ (yield gpm) <u>electric</u> (type power) (7) electric log <u>NO</u> (yes or no) (organization running log) (8) how well bottom plugged <u>Johnson</u> <u>BP Valve</u>	Blue clay	30	250
	good sand	250	400
	Blue clay	400	550
	Good sand	550	600
	Blue clay	600	890
	Good sand	890	924
DRILLERS REMARKS: <u>22 lbs. pressure</u> <u>2 joints galv. pipe on</u> <u>top</u>			


CODED

APR 13 1970

MISS. BD. OF  
WATER COMMISSIONERS  
JACKSON, MISSISSIPPI

If well telescopes please sketch and show depths.

GROUND LEVEL

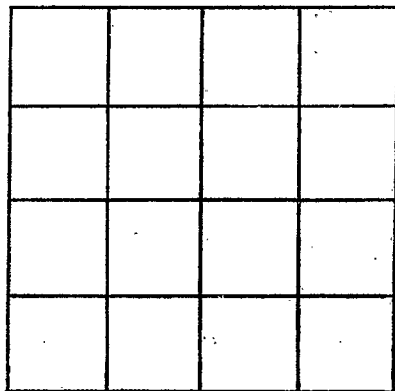

SECTION \_\_\_\_\_

Please indicate well location X.

ADDITIONAL INFORMATION

If more than one screen,  
show locations of each on sketch.