

Pearl River
T 40
4-15-70

MISSISSIPPI
 BOARD OF WATER COMMISSIONERS
 416 North State Street
 Jackson, Mississippi 39201

WATER WELL DRILLERS LOG

4-15
 date well completed

1970 NEIL LUMPKIN WELL DRILLING SERVICE
 P. O. BOX 117
 CARRIERE, MISS.

Pearl River
 county well located


LANDOWNER: <u>H. W. Ingram</u>	description of formations encountered	from	to
<u>Picayune</u> <u>Route</u> (mailing address)			
WELL LOCATION: <u>074</u> sec. <u>28</u> T. <u>5</u> R. <u>18</u> <u>8</u> miles <u>West</u> of <u>Picayune</u> (distance) (direction) (nearest town)	<u>surface clay</u>	<u>0</u>	<u>10</u>
WELL PURPOSE: <u>camp</u> (home, irrigation, municipal, industrial)	<u>surface sand + gravel</u> (had 2 sks. of mud)	<u>10</u>	<u>50</u>
WELL COMPLETION DATA: (1) diameter (inches) <u>2"</u> (2) total depth (feet) <u>195</u> (3) static water level (feet) <u>2</u> below above top of ground. (4) casing <u>galv.</u> (material) (depth) <u>2"</u> (size) If telescope see back. (5) screen <u>5'</u> (length) (depth to top) <u>2"</u> (size) <u>St. Steel</u> (material) (6) pump (HP) (yield gpm) (type power) (7) electric log <u>no</u> (yes or no) (organization running log) (8) how well bottom plugged <u>Johnson</u>	<u>hard blue clay</u>	<u>50</u>	<u>160</u>
	<u>fine to better sand</u>	<u>160</u>	<u>195</u>
DRILLERS REMARKS:			

JUN 1 1970

MISS. Bd. of
 WATER COMMISSIONERS

If well telescopes please sketch and show depths.

GROUND LEVEL

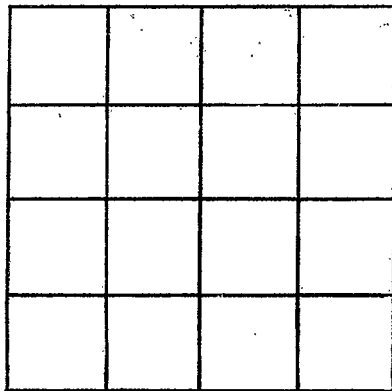

SECTION _____

Please indicate well location X.

ADDITIONAL INFORMATION

If more than one screen,
show locations of each on sketch.