

Pearl River
T 41
5-25-70

MISSISSIPPI
BOARD OF WATER COMMISSIONERS
416 North State Street
Jackson, Mississippi 39201

CODED

WATER WELL DRILLERS LOG

Pearl River

5-25-70 date well completed
Pearl River Well Serv firm name
Pearl River county well located

LANDOWNER: John Patch
P.O.
Pecayune Miss
(mailing address)

description of formations encountered	from	to
Surface clay	0	24
Sand + Gravel	24	90
Blue Clay	90	118
Brown sand	118	177
Blue Clay	177	285
Grey sand	285	415
Blue Clay	415	580
Grey sand	580	625
Blue Clay	625	878
Grey sand	878	890
Mud	890	980
Blue Clay	980	1100
Grey sand	1100	1160

WELL LOCATION:
sec. 32 T 5 R 18
8 miles NW of Pecayune
(distance) (direction) (nearest town)

WELL PURPOSE: FARM
(home, irrigation, municipal, industrial)

- WELL COMPLETION DATA:
- (1) diameter (inches) 2
 - (2) total depth (feet) 1160
 - (3) static water level (feet) Flow ^{below} above top of ground.
 - (4) casing Galv 1140
(material) (depth)
2 if telescope see back.
(size)
 - (5) screen 20' 1140
(length) (depth to top)
 - 015- 2" St. Steel
(size) (material)
 - (6) pump 60
(HP) (yield gpm)
 - (type power)
 - (7) electric log NO
(yes or no)
 - (organization running log)
 - (8) how well bottom plugged Blw. Valve

CODED


JUN 23 1970

MISS. BD. OF
WATER COMM.

DRILLERS REMARKS: 24 lbs
at ground level

If well telescopes please sketch and show depths.

GROUND LEVEL

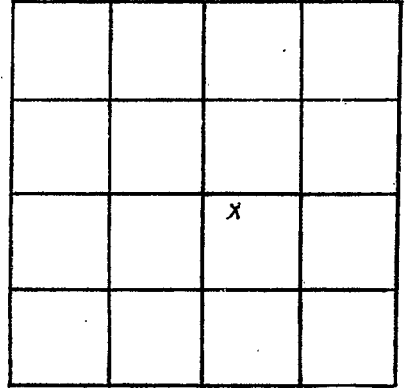

SECTION 22

Please indicate well location X.

ADDITIONAL INFORMATION

If more than one screen,
show locations of each on sketch.