

PEARL RIVER  
T43  
9-9-70

MISSISSIPPI  
BOARD OF WATER COMMISSIONERS  
416 North State Street  
Jackson, Mississippi 39201

**CODED**

WATER WELL DRILLERS LOG

9-9-70 date well completed      Penton Well Serv firm name      Pearl River county well located

LANDOWNER: Charles Speer  
P.O. 2 Box 228  
Picayune Miss  
(mailing address)

WELL LOCATION:  
sec. 36 T. 5 N R. 18 E  
S W  
5 miles N W of Picayune  
(distance) (direction) (nearest town)

WELL PURPOSE: Home  
(home, irrigation, municipal, industrial)

- WELL COMPLETION DATA:
- (1) diameter (inches) 2
  - (2) total depth (feet) 178
  - (3) static water level (feet) 12' below top of ground.
  - (4) casing Galv 173  
(material) (depth)  
2" if telescope see back.  
(size)
  - (5) screen 5' 173  
(length) (depth to top)  
2" S. Steel  
(size) (material)
  - (6) pump 1/2 (HP)  (yield gpm)  
Elec  
(type power)
  - (7) electric log NO  
(yes or no)
  - (organization running log)
  - (8) how well bottom plugged B.W. Value

description of formations encountered	from	to
Surface Clay	0	28
Sand + Gravel	28	70
Blue clay & Sand	70	122
Blue clay	122	160
Grey sand	160	178

**CODED**


UCT 8-1970

DRILLERS REMARKS:

MISS. BD. OF  
WATER COMM.

If well telescopes please sketch and show depths.

GROUND LEVEL

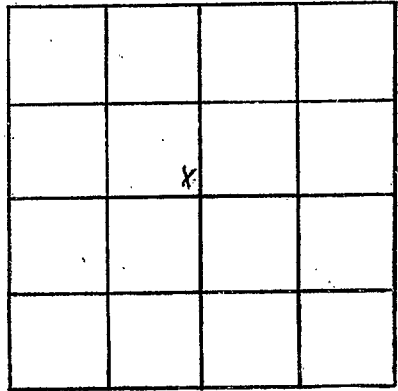

SECTION 36

Please indicate well location X.

ADDITIONAL INFORMATION

If more than one screen, show locations of each on sketch.