

PEARL RIVER
T 44
10-5-70

MISSISSIPPI
BOARD OF WATER COMMISSIONERS
416 North State Street
Jackson, Mississippi 39201

CODED

WATER WELL DRILLERS LOG

NEIL LUMPKIN WELL DRILLING SERVICE

P. O. BOX 117
CARRISBORO, MISS.

Pearl River

10-5-1970
date well completed

firm name

county well located

LANDOWNER: *George Lee Seal*
Picayune, Miss.
Route Industrial Comm.
(mailing address)

description of formations encountered

	from	to
--	------	----

WELL LOCATION:
sec. *35 T 5 S R 18 E*
8 miles *SW* of *Picayune*
(distance) (direction) (nearest town)

<i>Surface clay</i>	<i>0</i>	<i>20</i>
<i>Sand & Gravel</i>	<i>20</i>	<i>60</i>

WELL PURPOSE: *home*
(home, irrigation, municipal, industrial)

<i>Blue Clay</i>	<i>60</i>	<i>120</i>
<i>Grey sand</i>	<i>120</i>	<i>220</i>

WELL COMPLETION DATA:

<i>Blue Clay</i>	<i>220</i>	<i>340</i>
------------------	------------	------------

(1) diameter (inches) *2"*

<i>Good sand</i>	<i>340</i>	<i>500</i>
------------------	------------	------------

(2) total depth (feet) *798*

<i>Blue Clay</i>	<i>500</i>	<i>550</i>
------------------	------------	------------

(3) static water level (feet) _____ below above top of ground.

<i>Good grey sand</i>	<i>550</i>	<i>650</i>
-----------------------	------------	------------

(4) casing *Galv.* *778'*
(material) (depth)

<i>Blue Clay</i>	<i>650</i>	<i>700</i>
------------------	------------	------------

2" if telescope see back.
(size)

<i>Good sand</i>	<i>700</i>	<i>798</i>
------------------	------------	------------

(5) screen *20'*
(length) (depth to top)

2" *S. Steel*
(size) (material)

CODED

(6) pump _____ (HP) _____ (yield gpm)

(type power)

(7) electric log *no*
(yes or no)

18 lbs. pressure

(organization running log)

(8) how well bottom plugged *Johnson*
Back P. Habner

NOV 3 - 1970


DRILLERS REMARKS:

#2' feet galv. pipe on top of well

MISS. BD. OF
WATER COMMISSIONERS

If well telescopes please sketch and show depths.

GROUND LEVEL

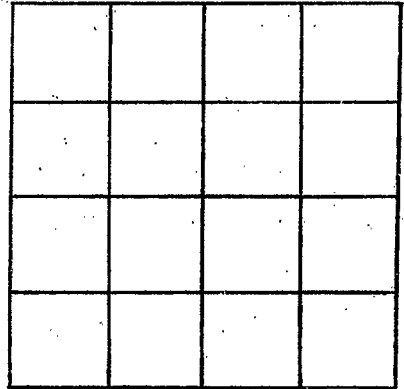

SECTION _____

Please indicate well location X.

ADDITIONAL INFORMATION

If more than one screen, show locations of each on sketch.