

PEARL RIVER
T 46
1-14-71

MISSISSIPPI
BOARD OF WATER COMMISSIONERS
416 North State Street
Jackson, Mississippi 39201

CODED

WATER WELL DRILLERS LOG

Pearl River

1-14

19 71 Pantan Well Serv

Pearl River

date well completed

firm name

county well located

LANDOWNER: Robert W. Carr
4212 Academy Drive
Meridian, Miss.
(mailing address)

description of formations encountered	from to	
	feet	feet
Surface Clay	0	40
Sand + Gravel	40	110
Blue Clay	110	200
Sand	200	380
Blue Clay	380	550
Sand	550	640
Blue Clay	640	880
Sand	880	950
Blue Clay	950	970
Sand	970	1049

WELL LOCATION:
sec. 3 T 5 N R 18 E
S W
2 miles NW of Cyber
(distance) (direction) (nearest town)

WELL PURPOSE: irrigation
(home, irrigation, municipal, industrial)

- WELL COMPLETION DATA:
- (1) diameter (inches) 2"
 - (2) total depth (feet) 1049
 - (3) static water level (feet) Flow ^{below} above top of ground.
 - (4) casing Black, 1029,
(material) (depth)
2" if telescope see back.
(size)
 - (5) screen 20', 1029
(length) (depth to top)
2", S. Steel
(size) (material)
 - (6) pump —, 48
(HP) (yield gpm)
Flow
(type power)
 - (7) electric log NO
(yes or no)
 - (organization running log)
 - (8) how well bottom plugged B.W. Valve


CODED

FEB 1 1971

DRILLERS REMARKS: 15 ft

If well telescopes please sketch and show depths.

GROUND LEVEL

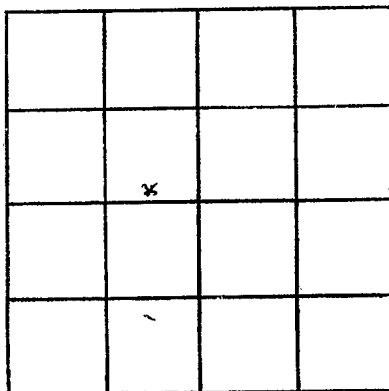

SECTION 3

Please indicate well location X.

ADDITIONAL INFORMATION

If more than one screen,
show locations of each on sketch.