

P.R.

T 48

7-11-73

MISSISSIPPI  
 BOARD OF WATER COMMISSIONERS  
 416 North State Street  
 Jackson, Mississippi 39201

CODED

WATER WELL DRILLERS LOG

7/11/73  
date well completed

Bud Pentone Son  
firm name

Pearl River  
county well located

LANDOWNER:

Michael Miller

description of formations encountered

from to

Picojun Miss.  
(mailing address)

white shale	0	18
white to sandy Rock	18	78
blue shale	70	168
blue sand.	168	200

WELL LOCATION:

sec. 33 T 85 N R 18 E  
 4 miles W of Picojun  
 (distance) (direction) (nearest town)

WELL PURPOSE:

home (home, irrigation, municipal, industrial)

WELL COMPLETION DATA:

- (1) diameter (inches) 2'
- (2) total depth (feet) 200
- (3) static water level (feet) 8 1/2 below top of ground.
- (4) casing gov 195 (material), (depth)

CODED

if telescope see back. (size)

- (5) screen 2x5 (length), 195 (depth to top)

2x5 gov #10 (size) (material)


- (6) pump 1/2 (HP), 5-20 (yield gpm)

Elect (type power)

- (7) electric log no (yes or no)

(organization running log)

- (8) how well bottom plugged sand

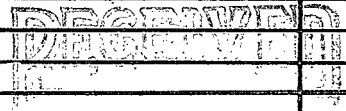


JAN 7 1974

DRILLERS REMARKS:

If well telescopes please sketch and show depths.

GROUND LEVEL

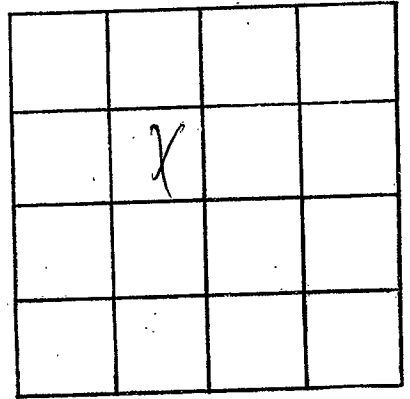

SECTION \_\_\_\_\_

Please indicate well location X.

ADDITIONAL INFORMATION

If more than one screen, show locations of each on sketch.