

P.R.
T 49
12-6-73

MISSISSIPPI
BOARD OF WATER COMMISSIONERS
416 North State Street
Jackson, Mississippi 39201

WATER WELL DRILLERS LOG

12-6-1973 date well completed
 Bud Cortens Son firm name
 Pearl River county well located

LANDOWNER:

Carrie, Miss.

description of formations encountered

Red Shale
 Red sand
 Blue shale
 Blue sand

from	to
0	18
18	90
90	220
220	268

(mailing address)

WELL LOCATION:

sec. 26 T 8 N R 18 E
 12 50 W of Carrie
 (distance) (direction) (nearest town)

WELL PURPOSE:

Home (home, irrigation, municipal, industrial)

WELL COMPLETION DATA:

- (1) diameter (inches) 2 1/2
- (2) total depth (feet) 268
- (3) static water level (feet) 23 below top of ground.
- (4) casing Galv. 263 (material) (depth)

(size) if telescope see back.

- (5) screen 215 263 (length) (depth to top)
 215 S.S. NO. 12 (size) (material)

- (6) pump 1 (HP) (yield gpm)
 electric (type power)

- (7) electric log NO (yes or no)

(organization running log)

- (8) how well bottom plugged Sand Shark


DRILLERS REMARKS:

CODED

REGISTERED
 JAN 7 1974

If well telescopes please sketch and show depths.

GROUND LEVEL

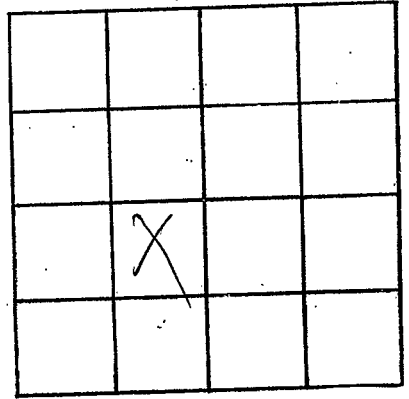

SECTION _____

Please indicate well location X.

ADDITIONAL INFORMATION

If more than one screen, show locations of each on sketch.