

P.R.
T50
11-3-73

MISSISSIPPI
BOARD OF WATER COMMISSIONERS
416 North State Street
Jackson, Mississippi 39201

CODED

WATER WELL DRILLERS LOG

11-3-73 date well completed
Bud Centeno, Son firm name
Pearl River county well located

LANDOWNER: Wayne Childs
Pearl River, Miss.

(mailing address)

WELL LOCATION:

sec. 23 T 5 N R 18 E
8 miles W of Pear.
(distance) (direction) (nearest town)

WELL PURPOSE: Home
(home, irrigation, municipal, industrial)


WELL COMPLETION DATA:

- (1) diameter (inches) 2 1/2
- (2) total depth (feet) 1143
- (3) static water level (feet) 24 below top of ground.
- (4) casing Galv. 1118 (material) (depth)
- (5) screen 2125, 1118 (length) (depth to top)
2125, S.S. 1012 (size) (material)
- (6) pump flow (HP) (yield gpm)
- (7) electric log NO (yes or no)
- (8) how well bottom plugged Sand Shark

description of formations encountered

description of formations encountered	from	to
Red shale	0	8
Sand & rock	8	90
Blue shale	90	125
Blue sand	125	380
Blue shale	380	463
Blue sand	463	470
Blue shale	470	660
Blue sand	660	860
Blue shale	860	1070
Blue sand	1070	1143

CODED

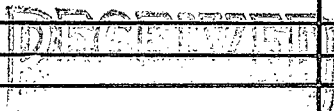


JAN 7 1974

DRILLERS REMARKS:

If well telescopes please sketch and show depths.

GROUND LEVEL

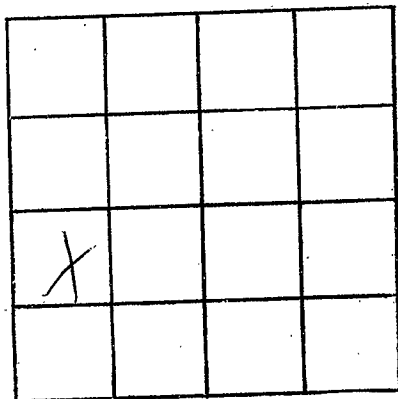

SECTION _____

Please indicate well location X.

ADDITIONAL INFORMATION

A series of horizontal lines for writing additional information.

If more than one screen, show locations of each on sketch.