

Pearl River
T 54
7-20-83

MISSISSIPPI DEPARTMENT OF NATURAL RESOURCES
 Bureau of Land and Water Resources
 Southport Mall
 P.O. Box 10631
 Jackson, Mississippi 39209
 WATER WELL DRILLERS LOG

CODED

7/20 1983
 date well completed

Pearl River
 firm name county well located

LANDOWNER:	description of formations encountered	from	to
<u>Boele Vaughn</u>	<u>white shale</u>	<u>0</u>	<u>10</u>
<u>R.T. - 2 Box 343</u>	<u>white sand</u>	<u>10</u>	<u>140</u>
<u>Pitajuno miss.</u> (mailing address)	<u>blue shale</u>	<u>140</u>	<u>230</u>
	<u>blue sand</u>	<u>230</u>	<u>410</u>
	<u>blue shale</u>	<u>410</u>	<u>660</u>
	<u>gray sand</u>	<u>660</u>	<u>735</u>
	<u>blue shale</u>	<u>735</u>	<u>1460</u>
	<u>gray sand</u>	<u>1460</u>	<u>1482</u>

WELL LOCATION:
 sec. 10 T 5 N R 18 E
 (distance) miles (direction) of Pitajuno (nearest town)

WELL PURPOSE: none
 (home, irrigation, municipal, industrial)

- WELL COMPLETION DATA:
- (1) diameter (inches) 2"
 - (2) total depth (feet) 1482
 - (3) static water level (feet) 22 ~~below~~ above top of ground.
 - (4) casing galv. 1482
 (material) (depth)
 (size) if telescope see back.
 - (5) screen 2x20 1462
 (length) (depth to top)
1/2 galv.
 (size) (material)
 - (6) pump no
 (HP) (yield gpm)
 (type power)
 - (7) electric log no
 (yes or no)
 (organization running log)
 - (8) how well bottom plugged sand
shark

CODED

DEPT. OF NATURAL RESOURCES
 BUREAU OF LAND & WATER RESOURCES


NOV 18 1983

RECEIVED

DRILLERS REMARKS:

If well telescopes please sketch and show depths.

GROUND LEVEL

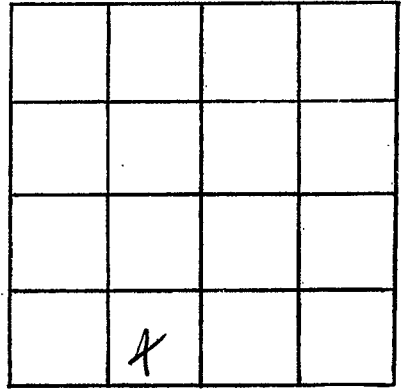

SECTION _____

Please indicate well location X.

ADDITIONAL INFORMATION

If more than one screen, show locations of each on sketch.