

MISSISSIPPI DEPARTMENT OF NATURAL RESOURCES

Bureau of Land and Water Resources

Southport Mall

P.O. Box 10631

Jackson, Mississippi 39209

WATER WELL DRILLERS LOG

CODED

T55
 Pearl River
 4-7-84

4/7 1984 Bud Porter Water Well Pearl River
 date well completed firm name county well located

LANDOWNER: Wayne Seal

RT 4 Box 24

Picayune Miss (mailing address)

WELL LOCATION:

sec 9 T 5 N R 18 E
 8 miles NW of Picayune
 (distance) (direction) (nearest town)

WELL PURPOSE: home
 (home, irrigation, municipal, industrial)

WELL COMPLETION DATA:

- (1) diameter (inches) 2"
- (2) total depth (feet) 1025'
- (3) static water level (feet) 184' below top of ground.
- (4) casing PVC, 1025' (material) (depth)
- (size) If telescope see back.
- (5) screen 2x20, 1005' (length) (depth to top)
- 12, PVC (size) (material)
- (6) pump 20 (HP) (yield gpm)
- (type power)
- (7) electric log No (yes or no)
- (organization running log)
- (8) how well bottom plugged sand

description of formations encountered	from	to
white shale	0	10
white rock	10	35
white sand	35	70
Blue shale	70	236
gray sand	236	320
blue shale	320	630
gray sand	630	700
blue shale	700	960
gray sand	960	1025

DEPT. OF NATURAL RESOURCES
 BUREAU OF LAND & WATER RESOURCES


JUL 10 1984

RECEIVED

DRILLERS REMARKS:

If well telescopes please sketch and show depths.

GROUND LEVEL

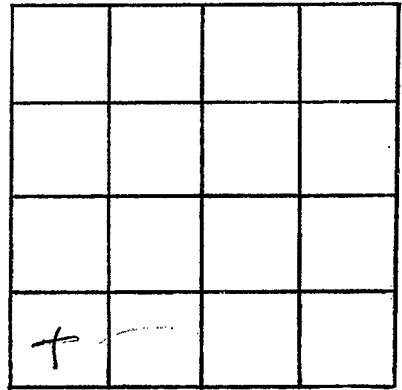

SECTION _____

Please indicate well location X.

ADDITIONAL INFORMATION

If more than one screen, show locations of each on sketch.