

MISSISSIPPI DEPARTMENT OF NATURAL RESOURCES

Bureau of Land and Water Resources

Southport Mall

CODED

P.O. Box 10631

Jackson, Mississippi 39209

WATER WELL DRILLERS LOG *Pearl River*

PEARL RIVER
T56

9/5 1984
date well completed

1984 *Brader Pump & Well Serv., Inc.*
firm name

Hancock
county well located

LANDOWNER: *Willie Willis*
Rt. 2, Box 840C
Bay St. Louis, Ms 39520
(mailing address)

description of formations encountered	from	to
<i>Clay - Surface</i>	<i>0</i>	<i>8</i>
<i>Red Clay</i>	<i>8</i>	<i>16</i>
<i>Red Sand</i>	<i>16</i>	<i>60</i>
<i>Sandy Gravel</i>	<i>60</i>	<i>120</i>
<i>White Clay</i>	<i>120</i>	<i>146</i>
<i>Blue Clay</i>	<i>140</i>	<i>270</i>
<i>Grey Sand</i>	<i>270</i>	<i>310</i>
<i>Blue Clay</i>	<i>310</i>	<i>+</i>

WELL LOCATION:
13 T 5 S R 18 W
5 miles *NW* of *Pearl River*
(distance) (direction) (nearest town)

WELL PURPOSE: *Home*
(home, irrigation, municipal, industrial)

WELL COMPLETION DATA:

(1) diameter (inches) *2"*

(2) total depth (feet) *320*

(3) static water level (feet) *70* below top of ground.

(4) casing *PVC* (material), *10'* (depth)

2" (size) if telescope see back.

(5) screen *10'* (length), *300 FF.* (depth to top)

2" (size), *PVC underbar* (material)

(6) pump *1* (HP), *10* (yield gpm)

230 V (type power)

(7) electric log *no* (yes or no)

CODED

(organization running log)

(8) how well bottom plugged *PVC sandshark*

DRILLERS REMARKS: *100' Red pipe*


DEPT. OF NATURAL RESOURCES
BUREAU OF LAND & WATER RESOURCES

NOV 9 1984

RECEIVED

If well telescopes please sketch and show depths.

GROUND LEVEL

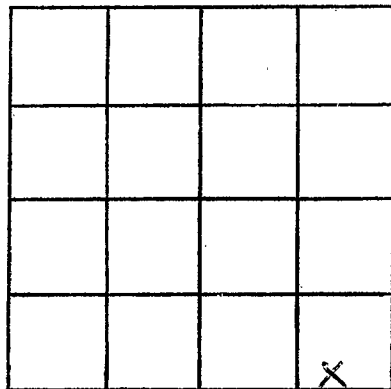

SECTION 13

Please indicate well location X.

ADDITIONAL INFORMATION

If more than one screen, show locations of each on sketch.