

MISSISSIPPI DEPARTMENT OF NATURAL RESOURCES

Bureau of Land and Water Resources

Southport Mall

P.O. Box 10631

Jackson, Mississippi 39209

WATER WELL DRILLERS LOG

CODED

PEARL RIVER
T57
10-7-85

10/7
date well completed

1985 PENION T57N
firm name

Pearl River
county well located

LANDOWNER: Stephen Steg
PO Box Pigeon
(mailing address)

description of formations encountered	from	to
Red shale	0	15
White sand	15	100
Blue shale	100	168
Sand & gravel	168	350
Blue shale	350	920
dry sand	920	970

WELL LOCATION:
sec. 23 T 5 N R 18 E
8 miles W of Pigeon
(distance) (direction) (nearest town)

WELL PURPOSE: home
(home, irrigation, municipal, industrial)

- WELL COMPLETION DATA:
- (1) diameter (inches) 2"
 - (2) total depth (feet) 970
 - (3) static water level (feet) 4 below above top of ground.
 - (4) casing PVC 970
(material) (depth)
20 If telescope see back.
(size)
 - (5) screen 2x20 95-0
(length) (depth to top)
1/2 PVC
(size) (material)
 - (6) pump 1/2 4250
(HP) (yield gpm)
E. Lect
(type power)
 - (7) electric log no
(yes or no)

(organization running log)

(8) how well bottom plugged Spud
Shank


DRILLERS REMARKS:

RECEIVED
NOV 26 1985

Department of Natural Resources
Bureau of Land & Water Resources

If well telescopes please sketch and show depths.

GROUND LEVEL

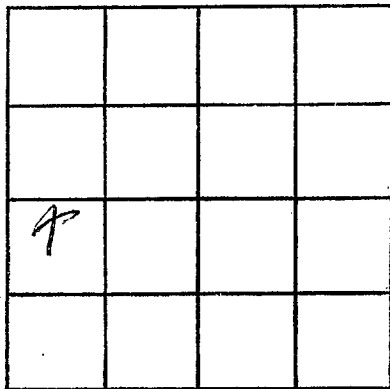

SECTION _____

Please indicate well location X.

ADDITIONAL INFORMATION

If more than one screen, show locations of each on sketch.