

MISSISSIPPI DEPARTMENT OF NATURAL RESOURCES

Bureau of Land and Water Resources

Southport Mall

P.O. Box 10631

Jackson, Mississippi 39209

WATER WELL DRILLERS LOG

BUD FENTON & SONS

Water Well Service Pearl River

firm name Box 402

county well located

Carriere, Mississippi 39426

CODED

PEARL RIVER
T 58

12/9 1985
date well completed

LANDOWNER: Clyde Wood

description of conditions encountered

R.T. 2 Box 145 Dierpine

miss. 39466
(mailing address)

WELL LOCATION:

sec. 26 T 5 N R 18 E
6 miles W of Dierpine
(distance) (direction) (nearest town)

WELL PURPOSE: home
(home, irrigation, municipal, industrial)

WELL COMPLETION DATA:

- (1) diameter (inches) 2
- (2) total depth (feet) 1472
- (3) static water level (feet) 16 below above top of ground.
- (4) casing gal. 1472
(material) (depth)
- no (size) if telescope see back.
- (5) screen 20' 145'-2
(length) (depth to top)
- 12 S.S. Steel
(size) (material)
- (6) pump 20
(HP) (yield gpm)
- no
(type power)
- (7) electric log no
(yes or no)

(organization running log)

(8) how well bottom plugged
S.S. Steel

DRILLERS REMARKS:

description of conditions encountered	from	to
Red shale	0	30
White sand	30	90
Blue shale	80	400
Blue sand	400	460
Blue shale	460	620
gray sand	620	680
Blue shale	680	1420
gray sand	1420	1472

CODED


RECEIVED

FEB 12 1986

Department of Natural Resources
Bureau of Land & Water Resources

If well telescopes please sketch and show depths.

GROUND LEVEL

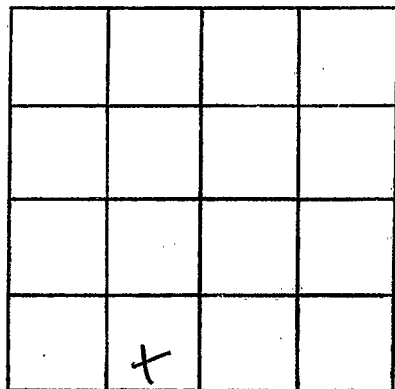

SECTION _____

Please indicate well location X.

ADDITIONAL INFORMATION

If more than one screen,
show locations of each on sketch.