

MISSISSIPPI DEPARTMENT OF NATURAL RESOURCES  
 Bureau of Land and Water Resources  
 Southport Mall  
 P.O. Box 10631  
 Jackson, Mississippi 39209  
**WATER WELL DRILLERS LOG**

CODED

PEARL RIVER  
 T 59

5-5 1986 PENTON WELL SERV. PEARL RIVER  
 date well completed firm name county well located

LANDOWNER: Mike Easterday  
 RT. ? Walkiah Bluff  
 PICAYUNE MS. 39466  
 (mailing address)

description of formations encountered	from	to
CLAY	0	10
GRAVEL	10	40
CLAY	40	100
SAND	100	480
CLAY	480	860
SAND	860	940


WELL LOCATION:  
 sec 30 T 5 N R 18 E  
 4 miles WEST of Picayune  
 (distance) (direction) (nearest town)

WELL PURPOSE: HOME  
 (home, irrigation, municipal, industrial)

WELL COMPLETION DATA:

- (1) diameter (inches) 2"
- (2) total depth (feet) 940'
- (3) static water level (feet) Flow below above top of ground.
- (4) casing PVC, 920' (material) (depth)  
 2" (size) if telescope see back.
- (5) screen 20', 920' (length) (depth to top)  
 2" (size) PVC (material)
- (6) pump (HP) (yield gpm)  
 (type power)
- (7) electric log No (yes or no)  
 (organization running log)
- (8) how well bottom plugged B.W.

CODED

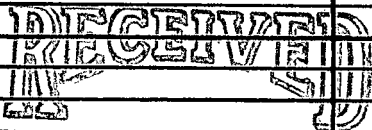


MAY 20 1986

Department of Natural Resources  
 Bureau of Land & Water Resources

DRILLERS REMARKS:

If well telescopes please sketch and show depths.

GROUND LEVEL

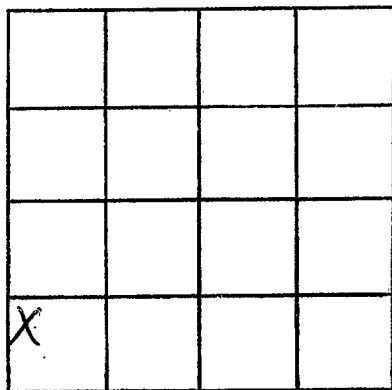

SECTION \_\_\_\_\_

Please indicate well location X.

ADDITIONAL INFORMATION

If more than one screen,  
show locations of each on sketch.