

Pearl River
T 60
11-67

MISSISSIPPI
BOARD OF WATER COMMISSIONERS
416 North State Street
Jackson, Mississippi 39201

WATER WELL DRILLERS LOG

11-30 date well completed
1967 Ponton Well Serv firm name
Pearl River county well located

LANDOWNER: J. E. Breland

description of formations encountered	from	to
Clay	0	16
Sand & Gravel	16	70
Blue Clay	70	158
Grey sand	158	186
Blue Clay	186	248
Grey Sand	248	262
Blue Clay	262	285
Grey Sand	285	357
Blue Clay	357	390
Grey Sand	390	430
Blue Clay	430	714
Fine Sand	714	750
Mud	750	780
Grey Sand	780	855

Rt. 2 Box 157 A (New Owner)

Picayune Miss (mailing address)

WELL LOCATION:


 6 miles NW of Picayune (distance) (direction) (nearest town)

WELL PURPOSE: Home (home, irrigation, municipal, industrial)

WELL COMPLETION DATA:

- (1) diameter (inches) 4 1/2
- (2) total depth (feet) 855
- (3) static water level (feet) Flow above top of ground.
- (4) casing Black, 835 (material) (depth)
2" If telescope see back. (size)
- (5) screen 20', 835 (length) (depth to top)
0.015 2", 3 steel (size) (material)
- (6) pump NO (HP) (yield gpm)
(type power)
- (7) electric log NO (yes or no)
(organization running log)
- (8) how well bottom plugged B.W. Falvo

New casing

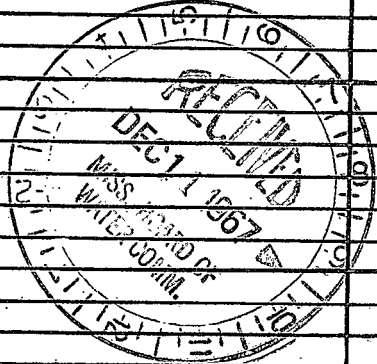

DRILLERS REMARKS: 16 lbs Shut in Pressure at Ground level

If well telescopes please sketch and show depths.

GROUND LEVEL

X			

SECTION 36

Please indicate well location X.

ADDITIONAL INFORMATION

If more than one screen,
show locations of each on sketch.