

Pearl River
T 63
5/8/76

MISSISSIPPI
 BOARD OF WATER COMMISSIONERS
 416 North State Street
 131 Jackson, Mississippi 39201

WATER WELL DRILLERS LOG

May 8 1976 Lumpkin Well Ser. Pearl River
 date well completed firm name county well located

LANDOWNER:
Mr. G. E. Marks
Picayune, Miss.
 (mailing address)

WELL LOCATION:
 sec. 29 T 5 N 8 R 78 E
8 miles W of Picayune
 (distance) (direction) (nearest town)

WELL PURPOSE: Home
 (home, irrigation, municipal, industrial)

- WELL COMPLETION DATA:
- (1) diameter (inches) 2"
 - (2) total depth (feet) 861'
 - (3) static water level (feet) 8" below above top of ground.
 - (4) casing Gal. 840'
 (material) (depth)
2" If telescope see back.
 (size)
 - (5) screen 21' 840'
 (length) (depth to top)
2" Stainless Steel
 (size) (material)
 - (6) pump None 40
 (HP) (yield gpm)
None
 (type power)
 - (7) electric log No
 (yes or no)
 - (organization running log)
 - (8) how well bottom plugged Sand Shell


| description of formations encountered | from to | |
|---------------------------------------|---------|-----|
| | | |
| Clay | 0 | 10 |
| Sand | 10 | 55 |
| Clay | 55 | 230 |
| Sand | 230 | 420 |
| Clay | 420 | 580 |
| Sand | 580 | 600 |
| Clay | 600 | 700 |
| Sand | 700 | 760 |
| Clay | 760 | 795 |
| Sand | 795 | 861 |

DRILLERS REMARKS:

MAY 27 1976

If well telescopes please sketch and show depths.

GROUND LEVEL

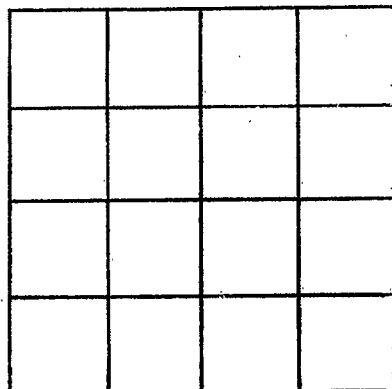

SECTION _____

Please indicate well location X.

ADDITIONAL INFORMATION

If more than one screen, show locations of each on sketch.