

Pearl River
T 64
5-11-76

MISSISSIPPI
 BOARD OF WATER COMMISSIONERS
 416 North State Street
 Jackson, Mississippi 39201

WATER WELL DRILLERS LOG

5-11 date well completed 13 ✓ 26 Memphis Well Dr. firm name Pearl River county well located

LANDOWNER:
Mr. S. E. Marko
New Orleans, La.
 (mailing address)

WELL LOCATION:
 sec. 35 T 5 N R 78 E
Eight miles West of Pearl River
 (distance) (direction) (nearest town)

WELL PURPOSE: Home
 (home, irrigation, municipal, industrial)

WELL COMPLETION DATA:
 (1) diameter (inches) 2"
 (2) total depth (feet) 860
 (3) static water level (feet) 4" below above top of ground.
 (4) casing Gal. 840'
 (material) (depth)
2" If telescope see back.
 (size)
 (5) screen 21' 840'
 (length) (depth to top)
2" Stainless Steel
 (size) (material)
 (6) pump None 386 G.P.M.
 (HP) (yield gpm)
None 20 LBS.
 (type power) (pressure)
 (7) electric log None
 (yes or no)
 (organization running log)
 (8) how well bottom plugged Sand Seal

description of formations encountered	from	to
Clay	0	6
Sand	6	30
Clay	30	40
Sand	40	80
Clay	80	125
Sand	125	220
Clay	220	355
Sand	355	460
Clay	460	625
Sand	625	735
Clay	735	785
Sand	785	860

RECEIVED


OCT 26 1976

MISS. BD. OF WATER COMMISSIONERS

DRILLERS REMARKS:

If well telescopes please sketch and show depths.

GROUND LEVEL

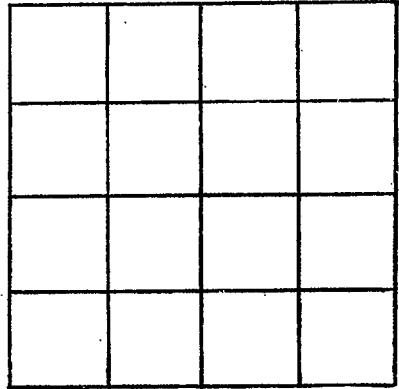

SECTION _____

Please indicate well location X.

ADDITIONAL INFORMATION

If more than one screen, show locations of each on sketch.