

Pearl River  
T 69  
7-20-82

MISSISSIPPI  
 BOARD OF WATER COMMISSIONERS  
 416 North State Street  
 Jackson, Mississippi 39201

WATER WELL DRILLERS LOG

7-20-82 19 Panton Well Service Pearl River  
 date well completed firm name county well located

LANDOWNER: <u>Troy Boone</u> <u>Rt. (dead check owner)</u>	description of formations encountered	from	to
<u>Picayune, MS.</u> (mailing address)			
	<u>Clay</u>	<u>7</u>	<u>48</u>
	<u>Clay</u>	<u>48</u>	<u>280</u>
	<u>Sand</u>	<u>280</u>	<u>405</u>
<b>WELL LOCATION:</b>			
sec. <u>28</u> T <u>5</u> R. <u>18</u> S <u>W</u>			
<u>6</u> miles <u>NW</u> of <u>Picayune</u> (distance) (direction) (nearest town)			
<b>WELL PURPOSE:</b> <u>Home</u> (home, irrigation, municipal, industrial)			
<b>WELL COMPLETION DATA:</b>			
(1) diameter (inches) <u>2</u>			
(2) total depth (feet) <u>405</u>			
(3) static water level (feet) <u>Flow</u> below above top of ground.			
(4) casing <u>PVC</u> <u>395</u> (material) (depth)			
<u>2</u> If telescope see back. (size)			
(5) screen <u>10'</u> <u>395</u> (length) (depth to top)			
<u>2</u> <u>PVC</u> (size) (material)			
(6) pump <input checked="" type="checkbox"/> (HP) <input checked="" type="checkbox"/> (yield gpm)			
<input checked="" type="checkbox"/> (type power)			
(7) electric log <u>NO</u> (yes or no)			
(organization running log)			
(8) how well bottom plugged <u>B.W. Valve</u>			
DRILLERS REMARKS:			


DEPT. OF NATURAL RESOURCES  
 BUREAU OF LAND & WATER RESOURCES

AUG 11 1982

RECEIVED

If well telescopes please sketch and show depths.

GROUND LEVEL

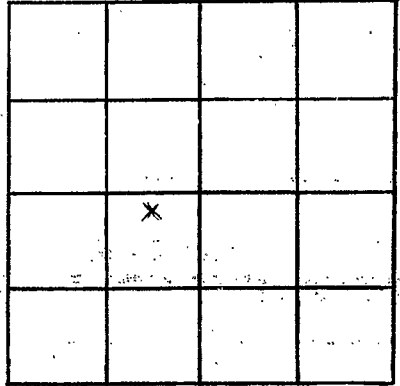

SECTION 28

Please indicate well location X.

ADDITIONAL INFORMATION

If more than one screen, show locations of each on sketch.