

Paul River
JTO
10-6-82

MISSISSIPPI
 BOARD OF WATER COMMISSIONERS
 416 North State Street
 Jackson, Mississippi 39201

WATER WELL DRILLERS LOG

10-6 19 82 Penton Well Serv Paul River
 date well completed firm name county well located

LANDOWNER: Thelus Mitchell
Rt.
Picayune MS.
 (mailing address)

description of formations encountered	from	to
Surface Clay	0	10
Sand	10	50
Blue Clay	50	280
Sand	280	458

WELL LOCATION:
 sec. 29 T 5 R 18
 S W
6 miles NW of Picayune
 (distance) (direction) (nearest town)

WELL PURPOSE: Home
 (home, irrigation, municipal, industrial)

- WELL COMPLETION DATA:
- (1) diameter (inches) 3
 - (2) total depth (feet) 458
 - (3) static water level (feet) Flow ^{below} top of ground.
 - (4) casing Pvc 448
 (material) (depth)
2" if telescope see back.
 (size)
 - (5) screen Pvc 448
 (length) (depth to top)
2 PVC
 (size) (material)
 - (6) pump
 (HP) (yield gpm)

 (type power)
 - (7) electric log NO
 (yes or no)
 (organization running log)
 - (8) how well bottom plugged BWVive

DRILLERS REMARKS:


DEPT. OF NATURAL RESOURCES
 BUREAU OF LAND & WATER RESOURCES

NOV - 8 1982

RECEIVED

If well telescopes please sketch and show depths.

GROUND LEVEL

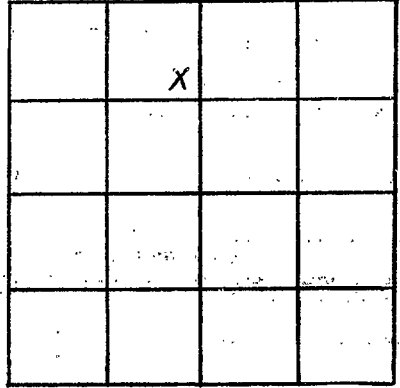

SECTION 39

Please indicate well location X.

ADDITIONAL INFORMATION

If more than one screen, show locations of each on sketch.