

MISSISSIPPI DEPARTMENT OF NATURAL RESOURCES

Bureau of Land and Water Resources

BUD PENTON & SON
 WATER WELL SERVICE
 ROUTE 4 BOX 462 P.O. Box 10631
 CARRIERS, MS 39203 Jackson, Mississippi 39209
 PHONE 793-6924
WATER WELL DRILLERS LOG

Pearl River
7-93
7.26-83

7/26 1983
 date well completed

firm name

Pearl River
 county well located

LANDOWNER: George Patterson

description of formations encountered

from to

R.T. 2 Box 274

Red Spale

0 10

Pisayune Miss.
 (mailing address)

sand & Rock

10 165

Blue shale

165 415

Blue sand

415 700

Blue spale

700 820

Grey sand

820 925

WELL LOCATION:

sec. 3 T. 5 N. R. 18 E.
12 1/2 miles NW of Pisayune
 (distance) (direction) (nearest town)

WELL PURPOSE: home
 (home, irrigation, municipal, industrial)

WELL COMPLETION DATA:

- (1) diameter (inches) 2"
- (2) total depth (feet) 925
- (3) static water level (feet) 17 below above top of ground.

(4) casing 900' 925'
 (material) (depth)

_____ if telescope see back.
 (size)

(5) screen 2x20 905'
 (length) (depth to top)

12 900'
 (size) (material)

(6) pump 30
 (HP) (yield gpm)

_____ (type power)

(7) electric log no
 (yes or no)

_____ (organization running log)

(8) how well bottom plugged hard
shorb

DEPT. OF NATURAL RESOURCES
 BUREAU OF LAND & WATER RESOURCES


NOV 18 1983

RECEIVED

DRILLERS REMARKS:

If well telescopes please sketch and show depths.

GROUND LEVEL

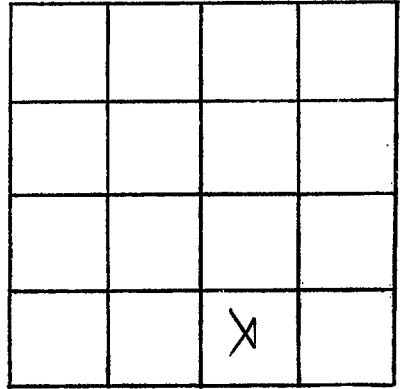

SECTION _____

Please indicate well location X.

ADDITIONAL INFORMATION

If more than one screen, show locations of each on sketch.