

MISSISSIPPI DEPARTMENT OF NATURAL RESOURCES

Bureau of Land and Water Resources

Southport Mall

P.O. Box 10631

Jackson, Mississippi 39209

WATER WELL DRILLERS LOG

SUD PENTON & SON
WATER WELL SERVICE
ROUTE 2 BOX 45
CANTON, MS 39426
PHONE 768-5324

pearl River
T 74

11/5 1981
date well completed

pearl River
county well located

LANDOWNER: Charles Cornetta

description of formations encountered	from	to
Red shell	0	26
W. hills sand & rock	26	105
Blue shell	105	175
Gray sand	175	276
Blue shell	276	605
Gray sand	605	890
Blue shell	890	1560
Gray sand	1560	1648

A.T. & prayers

Miss
(mailing address)

WELL LOCATION:

? sec 38 T 5 N R 18 E
26 miles West of Preppar
(distance) (direction) (nearest town)

WELL PURPOSE: None
(home, irrigation, municipal, industrial)

WELL COMPLETION DATA:

- (1) diameter (inches) 3"
- (2) total depth (feet) 1648
- (3) static water level (feet) 24 below above top of ground.
- (4) casing galv 1628
(material) (depth)
- TD if telescope see back.
(size)
- (5) screen 3x20 1628
(length) (depth to top)
- 16" Steel
(size) (material)
- (6) pump NO
(HP) (yield gpm)
- NO
(type power)
- (7) electric log NO
(yes or no)

(organization running log)

(8) how well bottom plugged plugged
shut

DEPT. OF NATURAL RESOURCES
BUREAU OF LAND & WATER RESOURCES


MAR 29 1982

RECEIVED

DRILLERS REMARKS:

If well telescopes please sketch and show depths.

GROUND LEVEL

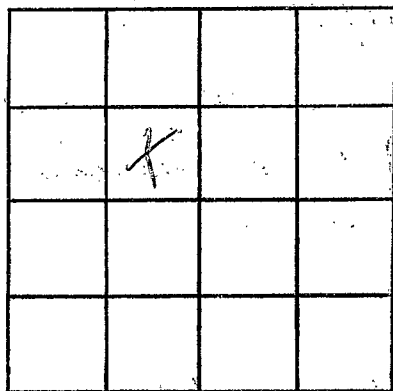

SECTION _____

Please indicate well location X.

ADDITIONAL INFORMATION

If more than one screen, show locations of each on sketch.