

MISSISSIPPI DEPARTMENT OF NATURAL RESOURCES

Bureau of Land and Water Resources

Southport Mall

P.O. Box 10631

Jackson, Mississippi 39209

WATER WELL DRILLERS LOG

PEARL RIVER
T 15
5/8/81

8


5/8 date well completed 1981 Red Pentas firm name Pearl River county well located

LANDOWNER: Douglas Smith	description of formations encountered	from	to
B-T- Bots	Red shale	0	12
Pleasure Miss. (mailing address)	Rocky sand	12	80
	Blue shale	80	300
	Gravel sand	300	360

WELL LOCATION:
sec. 6 T 5 N R 18 E
6 West miles West of Pearl River (distance) (direction) (nearest town)

WELL PURPOSE: home (home, irrigation, municipal, industrial)


- WELL COMPLETION DATA:
- (1) diameter (inches) 2"
 - (2) total depth (feet) 360
 - (3) static water level (feet) 0 below above top of ground.
 - (4) casing PVC 360 (material) (depth)
 - (5) screen 2 1/2 35-0 (length) (depth to top)
12 PVC (size) (material)
 - (6) pump NO (HP) (yield gpm)
 - (7) electric log NO (yes or no)
 - (8) how well bottom plugged Standard

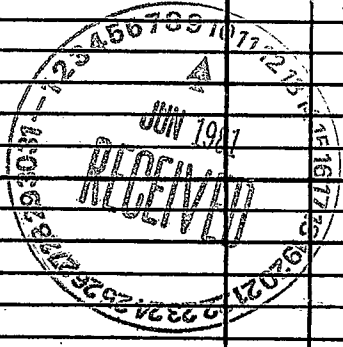

DRILLERS REMARKS:

If well telescopes please sketch and show depths.

GROUND LEVEL

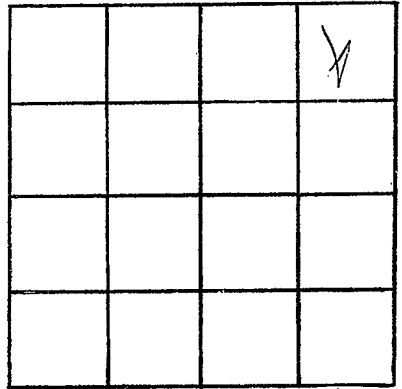

SECTION _____

Please indicate well location X.

ADDITIONAL INFORMATION

If more than one screen,
show locations of each on sketch.