

Pearl River  
T/74  
6-19-76

MISSISSIPPI  
 BOARD OF WATER COMMISSIONERS  
 416 North State Street  
 Jackson, Mississippi 39201

WATER WELL DRILLERS LOG

6-19-76 <sup>13V</sup> Bud Patten (Son Paul Patten)  
 date well completed firm name county well located

LANDOWNER: Roger Buxton  
Decatur, Mo.

description of formations encountered	from	to
<u>white s.s.</u>	<u>0</u>	<u>35</u>
<u>yellow sand</u>	<u>35</u>	<u>150</u>
<u>blue shale</u>	<u>150</u>	<u>365</u>
<u>blue sand</u>	<u>365</u>	<u>475</u>
<u>blue shale</u>	<u>475</u>	<u>701</u>
<u>blue sand</u>	<u>701</u>	<u>780</u>
<u>blue shale</u>	<u>780</u>	<u>870</u>
<u>blue sand</u>	<u>870</u>	<u>960</u>
<u>blue shale</u>	<u>960</u>	<u>980</u>
<u>gray</u>	<u>980</u>	<u>1012</u>

(mailing address)  
 WELL LOCATION:  
 sec 3 T 5 N R 18 E  
4.3 miles west of Waynes  
 (distance) (direction) (nearest town)

WELL PURPOSE: Home  
 (home, irrigation, municipal, industrial)

WELL COMPLETION DATA:

- (1) diameter (inches) 2 in
- (2) total depth (feet) 1012
- (3) static water level (feet) 194 <sup>below</sup> <sub>above</sub> top of ground.
- (4) casing shw 992  
 (material) (depth)  
 (size) if telescope see back.
- (5) screen 2x20 992  
 (length) (depth to top)  
2x Stantec Steel  
 (size) (material)
- (6) pump \_\_\_\_\_ (HP) \_\_\_\_\_ (yield gpm)  
fls  
 (type power)
- (7) electric log no  
 (yes or no)
- (organization running log) \_\_\_\_\_
- (8) how well bottom plugged  
sand shark


19.75  
 23 1/2  
 19.25  
 5.75  
 15.50  
 2.25  
 7.75

**RECEIVED**  
 SEP - 1 1976  
 MISS. BD. OF WATER CONTROL

DRILLERS REMARKS:

If well telescopes please sketch and show depths.

GROUND LEVEL

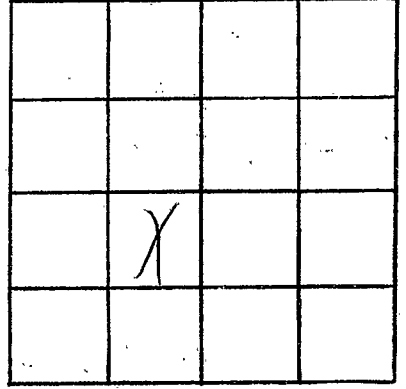

SECTION \_\_\_\_\_

Please indicate well location X.

ADDITIONAL INFORMATION

If more than one screen,  
show locations of each on sketch.