


If well telescopes please sketch and show depths.

GROUND LEVEL

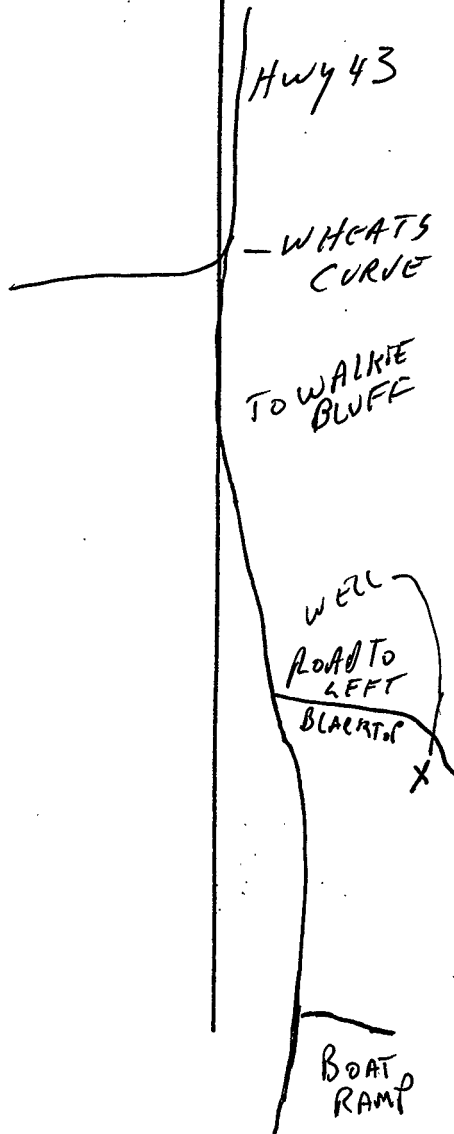

| | | | |
|---|--|--|--|
| | | | |
| | | | |
| | | | |
| X | | | |

SECTION 28

Please indicate well location X.

| | | | |
|------------------------------|---------------|---------------|-----|
| Pump Capacity (GPM) | No. of Stages | Setting Depth | FT. |
| PUMP TEST | | | |
| Well yielded _____ GPM with | | | |
| a drawdown of _____ ft. | | | |
| after _____ hours of pumping | | | |

LOG DATA

TYPE OF LOG RUN (Circle One): _____ No Log Run, Electric, Gamma Ray, Density, Sonic, Neutron, Other (Describe) _____

Name of Organization Running Log _____

GEOLOGIC DATA (Office Use Only)

| Surface Elev. | Geologic Unit | Unit Thickness | Depth to Top |
|---------------|---------------|----------------|--------------|
| Subs. SWL | Date | Analysis | Aquifer Test |

Driller's Remarks

If more than one screen, show location of each on sketch.