

State Well Report

Part 1

Mississippi Department of Environmental Quality
Office of Land and Water Resources
P.O. Box 10631
Jackson, MS 39289-0631
(601)961-5210
(601)354-6938 (fax)

For Office Use Only:

Aquifer: _____
Well #: T-91
L. S. Elevation: _____
E-log #: _____

County: Pearl River
Permit #: _____
Driller: Reece Penton
Date drilling completed: 10-26-05

State Law requires that this report be prepared by the driller in detail and filed with the Department within 30 days of completion of drilling of the well.

Well Owner Information	Well Location
Owner Name: <u>Roch Canzoneli</u>	Latitude: <u>30° 34' 02" N</u> Longitude: <u>89° 45' 13" W</u>
Mailing Address: <u>29 Arrowhead Rd</u>	Method of Lat/Long (circle one): <u>Conventional Survey</u>
<u>Picayune MS 39466</u>	USGS quad, <u>Hand-held GPS</u> , Survey-grade GPS <u>18W</u>
<u>Picayune MS 39466</u>	<u>1R</u> ¼ <u>SE</u> ¼ Sec <u>36</u> Twn <u>5S</u> Rng <u>17W</u>
City State Zip Code	Distance Direction Nearest Town
Telephone No. <u>(504) 512-2643</u>	<u>5</u> Miles <u>W</u> of <u>Picayune</u>

Well Data

Purpose of Well (circle one) Home Industrial Public Supply Irrigation Fish Culture Other: _____

Date well drilling started: 10-25-05 Date well drilling completed: 10-26-05

If flowing, method of flow regulation: Valve _____ Other (describe) _____

Static Water Level: 14 feet above or below (circle one) land surface Date measured: 10-26-05

Method of Measurement (circle one) steel tape electric tape air line other: _____

Hole depth: 440 Well depth: 440 Well grouted to a depth of 10 feet

Type of grout (circle one): Cement Bentonite Mix

Casing length: 430 feet Casing diameter: 4 inches Type of casing: PVC

Screen length: 10 feet Screen diameter: 2 inches Type of screen: PVC

Screen slot size: .010 inches Setting depth: From 420 feet to 430 feet

Type of completion (circle all applicable): Gravel packed Underreamed Telescoped Open hole Natural Development

Other (describe): _____

Top of lap pipe or reduction in casing: 100 feet. If telescoped or more than one screen, describe on back of page

Logs run (circle all applicable): No log run Electric Gamma Ray Density Sonic Neutron Other: _____

Name of organization running log(s): _____

I certify that the well was drilled, constructed, and completed in accordance with all applicable requirements of the Mississippi Department of Environmental Quality and/or the Mississippi Department of Health regulations and state laws.

Reece Penton 0-561
Print Name of Water Well Contractor and License No.

Reece Penton
Signature of Water Well Contractor

RECEIVED
DEC 01 2005
BY: OLWR

STATE WELL REPORT

Part 2

Pump Installer's Completion Report
 Mississippi Department of Environmental Quality
 Office of Land and Water Resources
 P.O. Box 10631
 Jackson, MS 39289-0631
 (601)961-5210
 (601)354-6938 (fax)

For Office Use Only:

Aquifer: _____
 Well #: T-91
 Elevation: _____

County: Pearl River
 Permit #: _____
 Driller: Reece Penton
 Date completed: 10-26-05

This report should be prepared by the pump installer in detail and filed with the Department within 30 days of the installation of pump.

Well Owner Information	Well Location
Owner Name: <u>Roch Canzoneli</u>	Latitude: <u>30° 34.023</u> Longitude: <u>89° 45.113</u> <u>02</u> <u>02</u>
Mailing Address: <u>Arrowhead Rd</u>	Method of Lat/Long (circle one): Conventional Survey,
<u>Picayune Ms 38466</u>	USGS quad, Hand-held GPS, Survey-grade GPS
City State Zip Code	<u>1/4 1/4 Sec 36 Twn 55 Rng 17W</u>
Telephone No. () _____	Distance Direction Nearest Town
	<u>5 Miles W of Picayune</u>

Pump Type Circle one	Power Type Circle one
Air Lift Jet <input type="radio"/> <input checked="" type="radio"/> <u>Submersible</u>	Diesel Engine Gasoline Engine Natural Gas
Bucket Piston Turbine	<input checked="" type="radio"/> <u>Electric Motor</u> Hand Tractor PTO
Centrifugal Rotary Flowing Well	Windmill Other (specify): _____
Other (specify): _____	Horse Power Rating of Motor: <u>1</u>
Date Pump Installed: <u>10-26-05</u>	Setting Depth: <u>45</u> feet
Rated Pump Capacity: <u>20</u> Gallons Per Minute	Number of Stages: <u>9</u>

Pump Test Data	Method of Measuring Water Level Circle one
Date Well Tested: <u>10-26-05</u>	Air Line Electric Measuring Line <input checked="" type="radio"/> <u>Steel Tape</u>
Static Water Level (A): <u>14</u> Feet Below Land Surface	Other (specify): _____
Pumping Water Level (B): <u>20</u> Feet Below Land Surface	For flowing well, measured shut in head: _____ feet
Drawdown [(B) - (A)]: <u>6</u> Feet Below Land Surface	Well yielded <u>20</u> GPM with a drawdown of
Test Pumping Rate: <u>20</u> Gallons Per Minute	<u>6</u> feet after <u>4</u> hours of pumping
Duration of Pump Test (minimum 4 hours): <u>4</u> hours	

I HEREBY CERTIFY that the above statements are true to the best of my knowledge.


Reece Penton Reece Penton
 Print Name of Pump Installer and License No. (if applicable) Signature of Pump Installer

RECEIVED
 DEC 01 2005
 BY: OLWR

T-91

If well telescopes please sketch below and show depths.


Ground Level

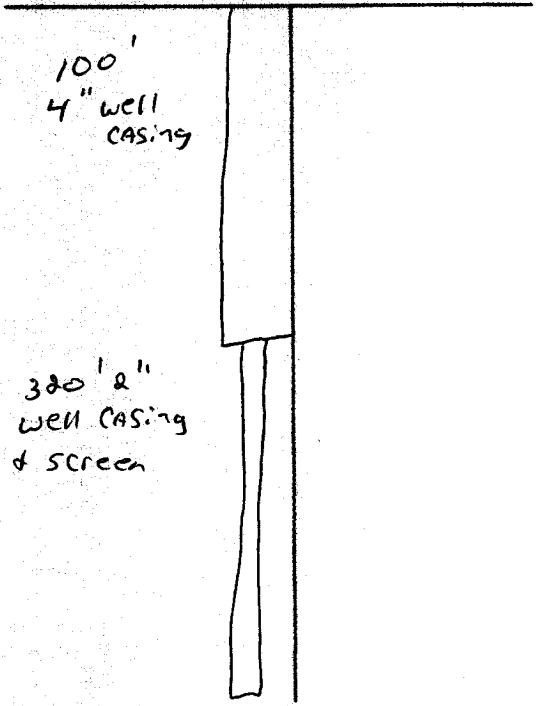

Description of Formations Encountered	From	To
CLAY	0	18
SAND	18	85
CLAY	85	150
SAND	150	225
CLAY	225	245
SAND	245	440

If more than one screen, show location of each on sketch

Sketch the property layout and include the following: 1) the well location; 2) any permanent structures on the property that may aid in locating the well; 3) any roads, power lines, or other items that may aid in locating the property and the well; 4) indicate direction.

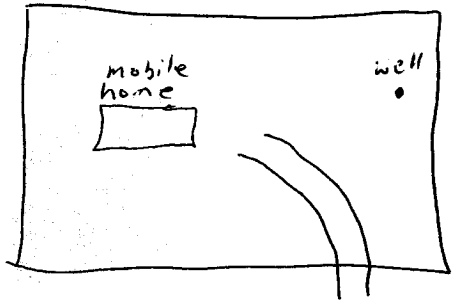

Landowner Name: Roch Canzoneli

Kecce Benton
Signature of Water Well Contractor

RECEIVED
DEC 01 2005
BY: OLWR