

**MISSISSIPPI
BOARD OF WATER COMMISSIONERS
416 North State Street
Jackson, Mississippi 39201**

WATER WELL DRILLERS LOG

11-67
T 2000
11-67

11-22 1967 Panther Well Serv Pearl River
date well completed firm name county well located

LANDOWNER: James Bennette

719 S. Curran Ave

Picayune Miss
(mailing address)

WELL LOCATION:

sec 35 T 5 S R 18 W
6 miles NW of Picayune
(distance) (direction) (nearest town)

WELL PURPOSE: Home
(home, irrigation, municipal, industrial)

WELL COMPLETION DATA:

(1) diameter (inches) 4 1/2"
(2) total depth (feet) 172
(3) static water level (feet) 17 below
top of ground.

(4) casing Galv steel 167
(material) (depth)

2"
(size) if telescope see back.

(5) screen 5', 167
(length) (depth to top)

.012 2", S. Steel
(size) (material)

(6) pump 1 10
(HP) (yield gpm)

Elec
(type power)

(7) electric log No
(yes or no)

(organization running log)


(8) how well bottom plugged Bl. Valve

description of formations encountered

from to


yellow clay	0	16
Whites	16	40
Sand + Gravel	40	75
Brown Mud	75	90
Blue clay	90	110
Sand	110	172

DRILLERS REMARKS:

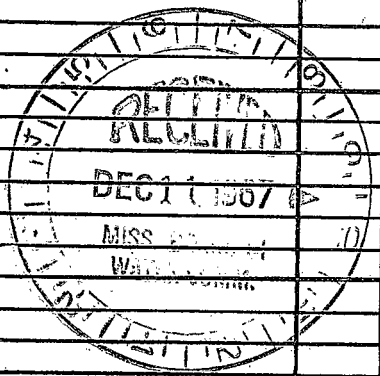

If well telescopes please sketch and show depths.

GROUND LEVEL

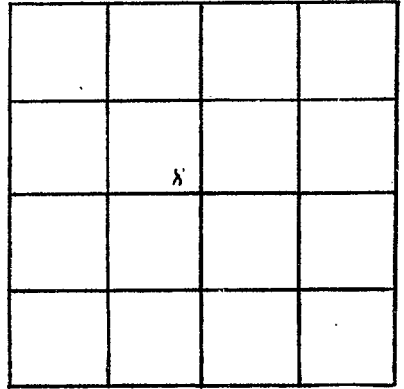

SECTION 35

Please indicate well location X.

ADDITIONAL INFORMATION

If more than one screen,
show locations of each on sketch.