

PEARL RIVER
T 2002
4-68

MISSISSIPPI
BOARD OF WATER COMMISSIONERS
416 North State Street
Jackson, Mississippi 39201

WATER WELL DRILLERS LOG

4-18-68 19 NEW LUMPKIN WELL Pearl River
date well completed firm name county well located
DRG. SERVICE


LANDOWNER: LOREN D. GLASS
COCK
CARRIERE, MISS. RT.
(mailing address)

description of fomations encountered	from	to
Surface Clay	0	20
Surface sand (red)	20	80
Blue Clay	80	170
Coar. grey sand	170	216

WELL LOCATION:
sec. 26 T. 5 S. R. 18 W.
4 miles NW of Piquin
(distance) (direction) (nearest town)

WELL PURPOSE: home
(home, irrigation, municipal, industrial)


- WELL COMPLETION DATA:
- (1) diameter (inches) 2"
 - (2) total depth (feet) 216'
 - (3) static water level (feet) 80 below top of ground.
 - (4) casing 2" galv. 210' (material) (depth)
2" (size) if telescope see back.
 - (5) screen 5' (length) (depth to top)
5" (size) St. Steel (material)
 - (6) pump 1 HP 600 gpm (HP) (yield gpm)
electric (type power)
 - (7) electric log no. (yes or no)
(organization running log)
 - (8) how well bottom plugged Johnson, RT Valve

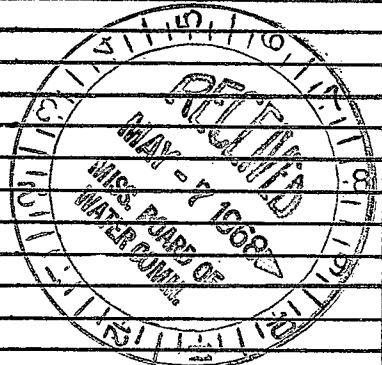

DRILLERS REMARKS:

If well telescopes please sketch and show depths.

GROUND LEVEL

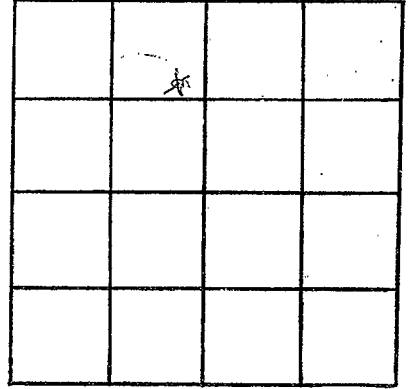

SECTION 26

Please indicate well location X.

ADDITIONAL INFORMATION

If more than one screen,
show locations of each on sketch.