

PEARL RIVER
T 2004
12-2-75

MISSISSIPPI
BOARD OF WATER COMMISSIONERS
416 North State Street
Jackson, Mississippi 39201

WATER WELL DRILLERS LOG

12/2 1975 Bud Penton Pearl River
date well completed firm name county well located

LANDOWNER: LPT Mallett

| description of formations encountered | from | to |
|---------------------------------------|------|-----|
| white shale | 0 | 26 |
| white sand | 26 | 152 |
| blue shale | 152 | 175 |
| blue sand | 175 | 195 |

Pearl River Miss -
(mailing address)

WELL LOCATION:
sec. 36 T 5 N R 18 E
4 miles (distance) of (direction) of (nearest town)

WELL PURPOSE: home
(home, irrigation, municipal, industrial)

WELL COMPLETION DATA:

- (1) diameter (inches) 2"
- (2) total depth (feet) 195
- (3) static water level (feet) 22 ft below top of ground
- (4) casing PVC, 185 (depth)
2" (size) if telescope see back.
- (5) screen 2x10, 185 (length) (depth to top)
1/2" (size), PVC (material)
- (6) pump no (HP) pump (yield gpm)
- (type power)
- (7) electric log no (yes or no)
- (organization running log)
- (8) how well bottom dug sand


DRILLERS REMARKS:



APR 12 1976

If well telescopes please sketch and show depths.

GROUND LEVEL

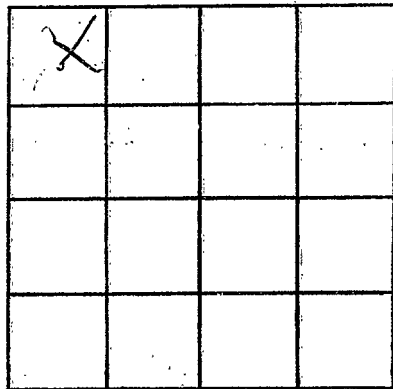

SECTION _____

Please indicate well location X.

ADDITIONAL INFORMATION

If more than one screen, show locations of each on sketch.