

PEARL RIVER
T 2005
3-5-76

MISSISSIPPI
 BOARD OF WATER COMMISSIONERS
 416 North State Street
 Jackson, Mississippi 39201

WATER WELL DRILLERS LOG

3-5
 date well completed

13V

Jackson, Mississippi 39201

1976 *Lumpkin Well Co. Pearl River*
 firm name county well located

LANDOWNER:
Jim Crowley
Pearl River, Miss.
 (mailing address)

description of formations encountered	from	to
<i>Clay</i>	<i>0</i>	<i>15</i>
<i>Sand</i>	<i>15</i>	<i>70</i>
<i>Clay</i>	<i>70</i>	<i>280</i>
<i>Gravel</i>	<i>280</i>	<i>345</i>

WELL LOCATION:
 sec 28 T. 5 N. R. 18 E
7 miles West of Pearl River
 (distance) (direction) (nearest town)

WELL PURPOSE: Home
 (home, irrigation, municipal, industrial)


- WELL COMPLETION DATA:
- (1) diameter (inches) 2"
 - (2) total depth (feet) 345'
 - (3) static water level (feet) 1' below top of ground.
 - (4) casing P.V.C., 330'
 (material) (depth)
2" if telescope see back.
 (size)
 - (5) screen 6', 339'
 (length) (depth to top)
2", P.V.C.
 (size) (material)
 - (6) pump 1/2, 18
 (HP) (yield gpm)
Elec.
 (type power)
 - (7) electric log No.
 (yes or no)
No.
 (organization running log)
 - (8) how well bottom plugged Small Shrub

DRILLERS REMARKS:

RECEIVED
 MAR 25 1976

If well telescopes please
sketch and show depths.

GROUND LEVEL

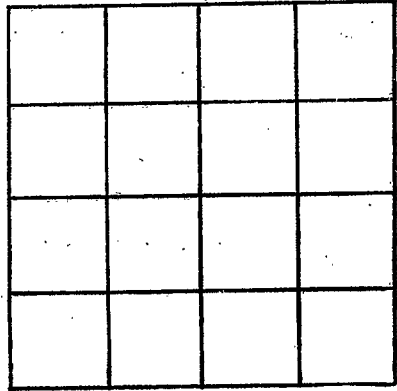

SECTION _____

Please indicate well location X.

ADDITIONAL INFORMATION

If more than one screen,
show locations of each on sketch.