

Pearl River  
T 2000  
5-27-76

MISSISSIPPI  
 BOARD OF WATER COMMISSIONERS  
 416 North State Street  
 Jackson, Mississippi 39201

WATER WELL DRILLERS LOG

5-27 1976 Paul Lester & Son Paul Lester  
 date well completed firm name county well located

LANDOWNER: Gene Anderson  
Peayune Rd  
 (mailing address)

description of formations encountered	from	to
<u>Red Shaly</u>	<u>0</u>	<u>18</u>
<u>white sand</u>	<u>18</u>	<u>56</u>
<u>Big rocks</u>	<u>56</u>	<u>85</u>
<u>Blue Shaly</u>	<u>85</u>	<u>150</u>
<u>Blue sand</u>	<u>150</u>	<u>178</u>

WELL LOCATION:  
 sec 35 T 5 N R 18 E  
3 miles NW of Peayune  
 (distance) (direction) (nearest town)

WELL PURPOSE: Home  
 (home, irrigation, municipal, industrial)


WELL COMPLETION DATA:

- (1) diameter (inches) 2 1/2
- (2) total depth (feet) 178
- (3) static water level (feet) 4 below top of ground.
- (4) casing Galv 108  
 (material) (depth)
- \_\_\_\_\_ if telescope see back.  
 (size)
- (5) screen 2x10, 108  
 (length) (depth to top)  
12 Stainless Steel  
 (size) (material)
- (6) pump 1 \_\_\_\_\_  
 (HP) (yield gpm)  
Electric  
 (type power)
- (7) electric log No  
 (yes or no)
- \_\_\_\_\_ (organization running log)
- (8) how well bottom plugged Good

DRILLERS REMARKS:

If well telescopes please sketch and show depths.

GROUND LEVEL

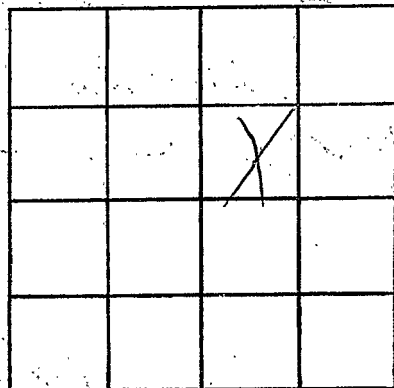

SECTION \_\_\_\_\_

Please indicate well location X.

ADDITIONAL INFORMATION

Lined area for additional information.

**RECEIVED**

SEP - 1 1976

If more than one screen, show locations of each on sketch.

MUSG. DR. OF WATER COM. 11  
MUSG. DR. OF WATER COM. 11