

Pearl River  
T 2007  
10/7/77

MISSISSIPPI  
BOARD OF WATER COMMISSIONERS  
416 North State Street  
Jackson, Mississippi 39201

WATER-WELL DRILLERS LOG

10-7 1977 Hunney water Pearl River  
date well completed firm name county well located

LANDOWNER: *Bob Boyd -  
Halefield RFD -  
MS.*  
(mailing address)

WELL LOCATION:  
sec. 35 T. 5 N. R. 18 E  
8 miles W of *Bayou*  
(distance) (direction) (nearest town)

WELL PURPOSE: *Home*  
(home, irrigation, municipal, industrial)

- WELL COMPLETION DATA:
- (1) diameter (inches) *2*
  - (2) total depth (feet) *250*
  - (3) static water level (feet) *150* below top of ground.
  - (4) casing *PVC*, *142* (material), (depth)  
*2* (size) if telescope see back.
  - (5) screen *2*, *142* (length), (depth to top)  
*2* (size), *PVC* (material)
  - (6) pump *1*, *5* (HP), (yield gpm)  
*20* (type power)
  - (7) electric log  (yes or no)
  - (organization running log)
  - (8) how well bottom plugged *Sealed.*

description of formations encountered	from	to
<i>Clay sdy.</i>	<i>0</i>	<i>16</i>
<i>Clay</i>	<i>16</i>	<i>186</i>
<i>sdy.</i>	<i>186</i>	<i>208</i>
<i>fine sd.</i>	<i>208</i>	<i>240</i>
<i>Sd Tight ml.</i>	<i>240</i>	<i>256</i>


RECEIVED  
MAR 31 1978

DRILLERS REMARKS:

MISS. Bd. OF WATER COMMISSIONERS

If well telescopes please sketch and show depths.

GROUND LEVEL

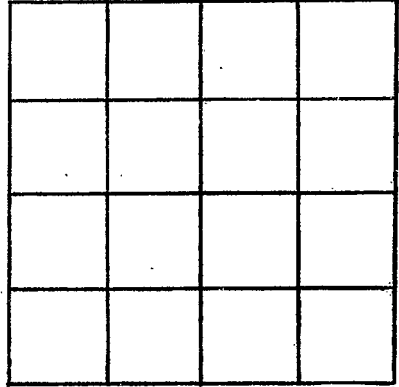

SECTION \_\_\_\_\_

Please indicate well location X.

ADDITIONAL INFORMATION

If more than one screen,  
show locations of each on sketch.