

Pearl R.
T 2008
11/1/77

MISSISSIPPI
BOARD OF WATER COMMISSIONERS
416 North State Street
Jackson, Mississippi 39201

WATER WELL DRILLERS LOG

11-1 date well completed
1977 Bud Benton firm name
Pearl River county well located

LANDOWNER:
L.O. Crosley Jr.
Bragg, Mrs
(mailing address)

description of formations encountered	from	to
Red shale	0	32
Red sand	32	150
Blue shale	150	250
Blue sand	250	280
Blue shale	280	360
Grey sand	360	399

WELL LOCATION:
sec. 4 T. 5 N R. 18 E
9 miles N-W of Bragg
(distance) (direction) (nearest town)

WELL PURPOSE: Home
(home, irrigation, municipal, industrial)

WELL COMPLETION DATA:

(1) diameter (inches) 2

(2) total depth (feet) 399

(3) static water level (feet) 74 below top of ground.

(4) casing Galv. 388 (material) (depth)

(size) if telescope see back.

(5) screen 2 x 10 388 (length) (depth to top)

12 Stainless Steel (size) (material)

(6) pump 1 450 15 (HP) (yield gpm)

electric (type power)

(7) electric log NO (yes or no)

(organization running log)

9 PM

(8) how well bottom plugged Sand Shale


DRILLERS REMARKS:

RECEIVED
DEC 30 1977

MISS. BD. OF WATER COMMISSIONERS

If well telescopes please sketch and show depths.

GROUND LEVEL

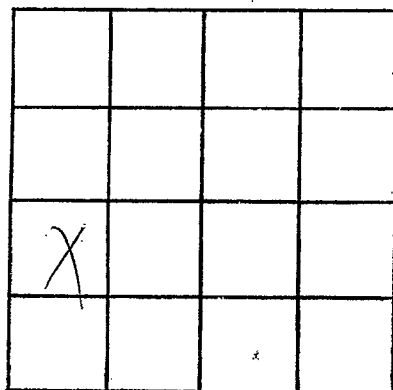

SECTION _____

Please indicate well location X.

ADDITIONAL INFORMATION

If more than one screen,
show locations of each on sketch.