

PEARL RIVER

T 2009

10-31-78

MISSISSIPPI BOARD OF WATER COMMISSIONERS 416 North State Street Jackson, Mississippi 39201

WATER WELL DRILLERS LOG

10/31 date well completed

1978 Bud Penton & Son firm name

Pearl River county well located

LANDOWNER: Pine Realty PO Box Piquette Miss (mailing address)

Table with 3 columns: description of formations encountered, from, to. Rows include Red shale, Sand gravel, Blue shale, Blue sand, Blue shale, Blue sand, Blue shale, Blue sand, Dry sand.

WELL LOCATION: sec 33 T 5 N R 18 E 10 miles W Piquette (distance) (direction) (nearest town)

WELL PURPOSE: home (home, irrigation, municipal, industrial)

- WELL COMPLETION DATA: (1) diameter (inches) 2" (2) total depth (feet) 765 (3) static water level (feet) 124 below top of ground (4) casing PVC 745 (material) (depth) No (size) If telescope see back. (5) screen 2x20 745 (length) (depth to top) 12 PVC (size) (material) (6) pump 1/2 650 (HP) (yield-gpm) 90+ Elect (type power) (7) electric log No (yes or no)

(organization running log)

(8) how well bottom plugged Sand/shark


DRILLERS REMARKS:

RECEIVED JAN 26 1978

MISS. BD. OF WATER COMMISSION

If well telescopes please sketch and show depths.

GROUND LEVEL

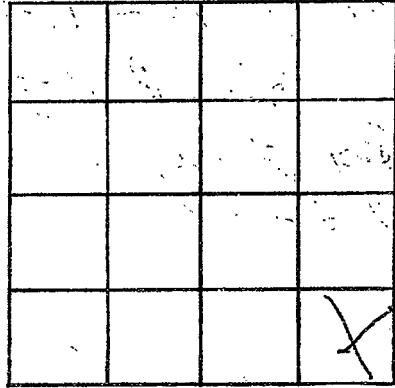

SECTION \_\_\_\_\_

Please indicate well location X.

ADDITIONAL INFORMATION

If more than one screen, show locations of each on sketch.