

PEARL RIVER
T 2010
10-20-78

MISSISSIPPI  
BOARD OF WATER COMMISSIONERS  
416 North State Street  
Jackson, Mississippi 39201

WATER WELL DRILLERS LOG

10/20 1978 Bud Penon sub. Pearl River  
date well completed firm name county well located

LANDOWNER: Frank Jones  
P.O. Piquette  
Miss.  
(mailing address)

WELL LOCATION:  
sec. 33 T 5 N R 18 E  
2 miles W of Piquette  
(distance) (direction) (nearest town)


WELL PURPOSE: home  
(home, irrigation, municipal, industrial)

- WELL COMPLETION DATA:
- (1) diameter (inches) 4"
  - (2) total depth (feet) 376
  - (3) static water level (feet) 28 below above-top of ground.
  - (4) casing pvc, 376, (material) (depth)  
(size) if telescope see back.
  - (5) screen 4x10, 366 (length) (depth to top)  
12, pvc (size) (material)
  - (6) pump 1/2 HP, 800 (yield.gpm)  
Elect (type power) 9PH
  - (7) electric log no (yes or no)

(organization running log)  
(8) how well bottom plugged Sand trap

DRILLERS REMARKS:


description of formations encountered	from	to
Red shale	0	20
White sand	65	110
Blue shell	110	325
Blue sand	325	376

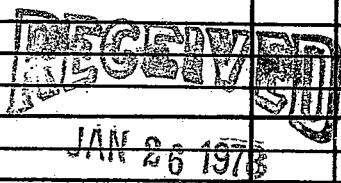

MISS. BD. OF WATER COMMISSIONERS

If well telescopes please sketch and show depths.

GROUND LEVEL

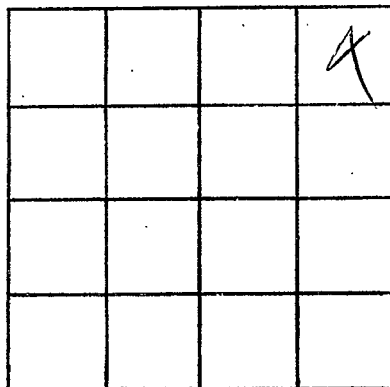

SECTION \_\_\_\_\_

Please indicate well location X.

ADDITIONAL INFORMATION

If more than one screen, show locations of each on sketch.