

MISSISSIPPI DEPARTMENT OF NATURAL RESOURCES

Bureau of Land and Water Resources

Southport Mall

P.O. Box 10631

Jackson, Mississippi 39209

WATER WELL DRILLERS LOG

Pearl River
T 2012
9-23-81

Sept 23 1981 - Walker Welding & Repair Pearl River
 date well completed Billy @ Walker firm name county well located

LANDOWNER:	description of formations encountered	from	to
Harvey Lett	White chalk	1	65
St. 6 Sicyone, Miss. (mailing address)	fine white sand	65	80
	blue shale	80	279
	blue sand	279	315
WELL LOCATION:			
sec. <u>29</u> T <u>5</u> N R <u>18</u> E S W			
<u>7</u> miles <u>N. W.</u> of <u>Sicyone</u> (distance) (direction) (nearest town)			
WELL PURPOSE: <u>Home</u> (home, irrigation, municipal, industrial)			
WELL COMPLETION DATA:			
(1) diameter (inches) <u>2"</u>			
(2) total depth (feet) <u>315'</u>			
(3) static water level (feet) <u>60</u> below top of ground. above			
(4) casing <u>PVC</u> , <u>315'</u> (material) (depth)			
(size) if telescope see back.			
(5) screen <u>10"</u> , <u>305'</u> (length) (depth to top)			
<u>12</u> , <u>PVC</u> (size) (material)			
(6) pump <u>1</u> , <u>6</u> (HP) (yield gpm)			
<u>electric</u> (type power)			
(7) electric log <u>no</u> (yes or no)			
(organization running log)			
(8) how well bottom plugged <u>Sand shank</u>			
DRILLERS REMARKS:			


DEPT. OF NATURAL RESOURCES
 BUREAU OF LAND & WATER RESOURCES

OCT - 6 1981

RECEIVED

If well telescopes please sketch and show depths.

GROUND LEVEL

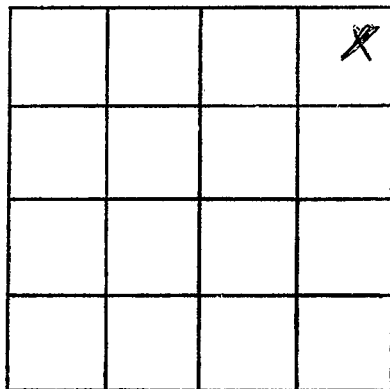

SECTION _____

Please indicate well location X.

ADDITIONAL INFORMATION

If more than one screen,
show locations of each on sketch.