

**MISSISSIPPI DEPARTMENT OF NATURAL RESOURCES**  
**Bureau of Land and Water Resources**  
 Southport Mall  
 P.O. Box 10631  
 Jackson, Mississippi 39209  
**WATER WELL DRILLERS LOG**

Pearl River  
T 2014

Nov 14 1981 Walker Wilder Pearl River  
 date well completed firm name county well located  
Reid Shop

Sec 24 in this T & R is in Picayune.

LANDOWNER: J. J. Masters  
3008 H. Ann Dr  
Gretna La  
 (mailing address)

description of formations encountered	from	to
<u>red shale</u>	<u>0</u>	<u>25</u>
<u>sand</u>	<u>25</u>	<u>95</u>
<u>Blue shale</u>	<u>97</u>	<u>235</u>
<u>conglomerate</u>	<u>235</u>	<u>252</u>
<u>sand &amp; gravel</u>		

WELL LOCATION:  
 sec 24 T 25 S R 18 E W  
10 miles NW Picayune  
 (distance) (direction) (nearest town)

WELL PURPOSE: Home  
 (home, irrigation, municipal, industrial)

- WELL COMPLETION DATA:
- diameter (inches) 4"
  - total depth (feet) 252
  - static water level (feet) 100 below above top of ground.
  - casing 4" PVC, 242 (material) (depth)  
 (size) if telescope see back.
  - screen 10 242 (length) (depth to top)  
12 PVC (size) (material)
  - pump 1 15 (HP) (yield gpm)  
Edco (type power)
  - electric log (yes or no)

DEPT. OF NATURAL RESOURCES  
 BUREAU OF LAND & WATER RESOURCES

NOV 23 1981


**RECEIVED**

(organization running log)  
 (8) how well bottom plugged and  
shave

DRILLERS REMARKS:

If well telescopes please sketch and show depths.

GROUND LEVEL

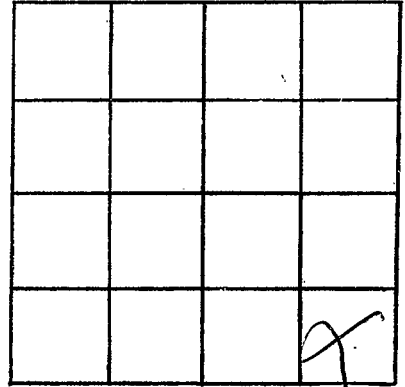

SECTION \_\_\_\_\_

Please indicate well location X.

ADDITIONAL INFORMATION

If more than one screen,  
show locations of each on sketch.