

MISSISSIPPI DEPARTMENT OF NATURAL RESOURCES

Bureau of Land and Water Resources

Southport Mall

P.O. Box 10631

Jackson, Mississippi 39209

WATER WELL DRILLERS LOG

BUD PENTON & SON
WATER WELL SERVICE
ROUTE 2 BOX 44
CARRIERS MS 39426
PHONE 782 5324

Paul River
T 2015

1/7 1982
date well completed

Paul River
county well located

LANDOWNER: Jim R. Suet
Dewey field com.

description of formations encountered	from	to
Red shale	0	22
Red sand	22	47
White shale	47	90
White sand	90	105
Blue shale	105	145
Gray sand	145	152
Blue shale	152	199
Gray sand	199	237

(mailing address)

WELL LOCATION:
sec. 13 T 7 N R 18 E
S W
6 miles W of Carrick
(distance) (direction) (nearest town)

WELL PURPOSE: Drinking
(home, irrigation, municipal, industrial)

WELL COMPLETION DATA:

- (1) diameter (inches) 4"
- (2) total depth (feet) 237
- (3) static water level (feet) 164 below above top of ground.
- (4) casing pvc 2.27
(material) (depth)
- (size) if telescope see back.
- (5) screen 10 227
(length) (depth to top)
- 10 pvc
(size) (material)
- (6) pump 1 650
(HP) (yield gpm)
- Elect
(type power)
- (7) electric log no
(yes or no)

(organization running log)

(8) how well bottom plugged Spand
Shank

DRILLERS REMARKS:


DEPT. OF NATURAL RESOURCES
BUREAU OF LAND & WATER RESOURCES

MAR 29 1982

RECEIVED

If well telescopes please sketch and show depths.

GROUND LEVEL

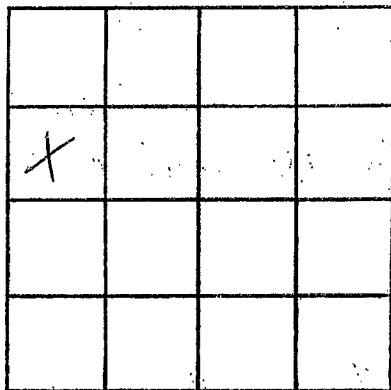

SECTION _____

Please indicate well location X.

ADDITIONAL INFORMATION

If more than one screen,
show locations of each on sketch.