

MISSISSIPPI DEPARTMENT OF NATURAL RESOURCES

BUD PENTON & SON  
 WATER WELL SERVICE  
 ROUTE 3 BOX 41  
 CARRIERE, MS 39426  
 PHONE 798-5324  
 JACKSON, MISSISSIPPI 39209  
 WATER WELL DRILLERS LOG

Pearl River  
Tadde

1-2/80 19  
 date well completed

Pearl River  
 county well located

LANDOWNER: MD. Brown  
PO Box 360 Picayune  
MS 39426  
 (mailing address)

description of formations encountered	from	to
<u>white shale</u>	<u>0</u>	<u>170</u>
<u>gray sand</u>	<u>172</u>	<u>192</u>

WELL LOCATION:  
 sec. 6 T. 5 N. R. 18 E.  
2 miles W. of Picayune  
 (distance) (direction) (nearest town)

WELL PURPOSE: None  
 (home, irrigation, municipal, industrial)

- WELL COMPLETION DATA:
- (1) diameter (inches) 2
  - (2) total depth (feet) 192
  - (3) static water level (feet) 23 below above top of ground.
  - (4) casing pvc, 18 ft,  
 (material) (depth)  
 (size) if telescope see back.
  - (5) screen 10', 18 ft  
 (length) (depth to top)  
1/2", pvc  
 (size) (material)
  - (6) pump 1/2, 45-0  
 (HP) (yield gpm)  
Elect.  
 (type power)
  - (7) electric log no  
 (yes or no)
  - (organization running log)
  - (8) how well bottom plugged good  
Mark

DRILLERS REMARKS:


DEPT. OF NATURAL RESOURCES  
 BUREAU OF LAND & WATER RESOURCES

MAR 29 1982

RECEIVED

If well telescopes please sketch and show depths.

GROUND LEVEL

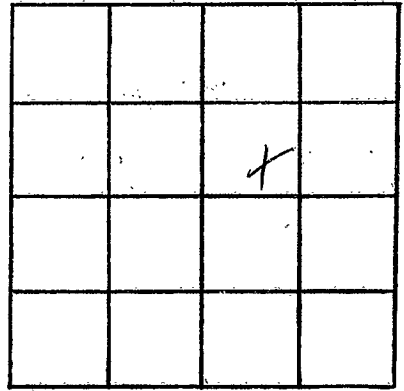

SECTION \_\_\_\_\_

Please indicate well location X.

ADDITIONAL INFORMATION

If more than one screen,  
show locations of each on sketch.