

MISSISSIPPI DEPARTMENT OF NATURAL RESOURCES

Bureau of Land and Water Resources

BUD PENTON & SONS Southport Mall
 WATER WELL SERVICE
 ROUTE 3 BOX 41 P.O. Box 10631
 CARRIERE, MS 39426
 PHONE 798-5521

WATER WELL DRILLERS LOG

Paul River
T 207

1/28 1982
 date well completed

Paul River
 firm name county well located

LANDOWNER: Mutcarrell
R. J. & Patricia
 (mailing address)

WELL LOCATION:
 sec. 6 T. 5 N. R. 18 E
 S. W.
1/4 miles W of Signature
 (distance) (direction) (nearest town)

description of formations encountered	from	to
Red shale	0	20
White sand	20	59
Blue shale	59	126
White sand	126	147
Blue shale	147	157
Gray sand	157	190

WELL PURPOSE: home
 (home, irrigation, municipal, industrial)

WELL COMPLETION DATA:

(1) diameter (inches) 2"

(2) total depth (feet) 190

(3) static water level (feet) 92 below above top of ground.

(4) casing PVC / 180
 (material) (depth)
 (size) if telescope see back.

(5) screen 10 / 180
 (length) (depth to top)
10 / PVC
 (size) (material)

(6) pump 1/4 / 530
 (HP) (yield gpm)
Electric
 (type power)

(7) electric log no
 (yes or no)

(organization running log)

(8) how well bottom plugged Sand

DRILLERS REMARKS: Short


DEPT. OF NATURAL RESOURCES
 BUREAU OF LAND & WATER RESOURCES

MAR 20 1982

RECEIVED

If well telescopes please sketch and show depths.

GROUND LEVEL

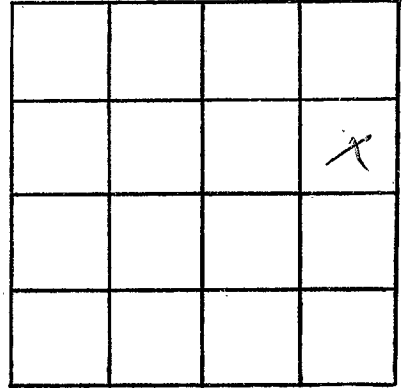

SECTION _____

Please indicate well location X.

ADDITIONAL INFORMATION

If more than one screen,
show locations of each on sketch.