

Pearl River
T 209

MISSISSIPPI
 BOARD OF WATER COMMISSIONERS
 416 North State Street
 Jackson, Mississippi 39201

WATER WELL DRILLERS LOG

9-30
 date well completed

19 82 Penton Well Serv
 firm name

Pearl River
 county well located

LANDOWNER: Clarence Wheat
Rt.
Picayune MS-
 (mailing address)

WELL LOCATION:
 sec. 30 T 5 N R. 18 W
6 miles N.W. of Picayune
 (distance) (direction) (nearest town)

WELL PURPOSE: Home
 (home, irrigation, municipal, industrial)

- WELL COMPLETION DATA:
- (1) diameter (inches) 2
 - (2) total depth (feet) 465
 - (3) static water level (feet) 2 below
 top of ground.
 - (4) casing PVC 455
 (material) (depth)
2 if telescope see back.
 (size)
 - (5) screen 10' 455
 (length) (depth to top)
2 PVC
 (size) (material)
 - (6) pump 1/2 10
 (HP) (yield gpm)
Elec
 (type power)
 - (7) electric log NO
 (yes or no)
- (organization running log)
- (8) how well bottom plugged B W Valve

description of formations encountered	from	to
Surface Clay	0	10
Sand	10	60
Clay	60	100
Sand	100	170
Blue Clay	170	280
Sand	280	350
Blue Clay	350	380
Sand	380	465

DEPT. OF NATURAL RESOURCES
 BUREAU OF LAND & WATER RESOURCES


NOV 8 1982

RECEIVED

DRILLERS REMARKS:

If well telescopes please sketch and show depths.

GROUND LEVEL

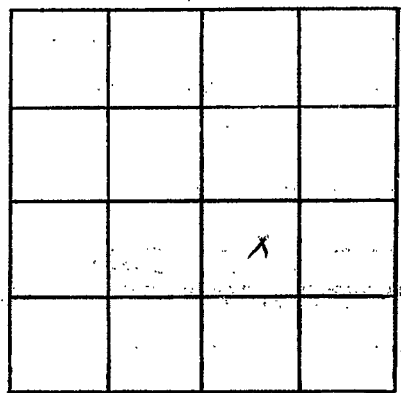

SECTION 30

Please indicate well location X.

ADDITIONAL INFORMATION

If more than one screen, show locations of each on sketch.