

MISSISSIPPI DEPARTMENT OF NATURAL RESOURCES

Bureau of Land and Water Resources

Southport Mall

P.O. Box 10631

Jackson, Mississippi 39209

WATER WELL DRILLERS LOG

Paul River

T 2000

BUD PENTON & SON
 WATER WELL SERVICE
 ROUTE 4, BOX 462
 CARRIER # MS 39826
 PHONE 798-5924

date well completed 19 _____

Paul River
 county well located

LANDOWNER: Andy Green

R.T. 5 Poyune

(mailing address)

description of formations encountered

from

to

white shale	0	21
white sand	21	62
blue shale	62	235
blue sand	235	295

WELL LOCATION:

sec. 24 T. 5 N R. 18 E
 S W
6 miles SW of Poyune
 (distance) (direction) (nearest town)

WELL PURPOSE: none
 (home, irrigation, municipal, industrial)

WELL COMPLETION DATA:

- (1) diameter (inches) 2"
- (2) total depth (feet) 295'
- (3) static water level (feet) 134' below above top of ground.
- (4) casing pvc, 295'
 (material) (depth)
- _____ If telescope see back.
 (size)
- (5) screen 2x10, 285'
 (length) (depth to top)
- 1/2", pvc
 (size) (material)
- (6) pump 1/2 2000
 (HP) (yield gpm)
- Elect
 (type power)
- (7) electric log no
 (yes or no)

_____ (organization running log)

(8) how well bottom plugged sand
shale

DRILLERS REMARKS:


DEPT. OF NATURAL RESOURCES
 BUREAU OF LAND & WATER RESOURCES

DEC - 1 1982

RECEIVED

If well telescopes please sketch and show depths.

GROUND LEVEL

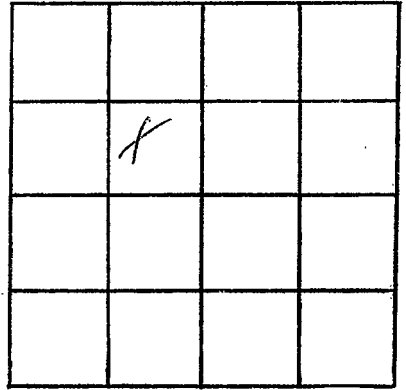

SECTION _____

Please indicate well location X.

ADDITIONAL INFORMATION

If more than one screen,
show locations of each on sketch.